

CHICKASAW MISSISSIPPI BOARD OF WATER COMMISSIONERS

H 19 5 13L

H300

7-8-60

WATER WELL DRILLERS LOG  
Herndon Well & Supply Co.  
SHANNON, MISS.

Date: July 8, 1960, Driller: \_\_\_\_\_ County Chickasaw

(Name)

CODED

(1) Owner of Land: <u>Bob Loeth</u> (Name)	Description & Color of Materials Sand, Clay, Red Clay, Shell, etc.	Thick- ness Feet	Depth Feet
<u>Okolona, Mississippi</u> (Address)	<u>Sand &amp; Clay</u> <u>to</u>		<u>23</u>
(2) Location: <u>1/4, 1/4, Sec 14 T13 S</u>	<u>Blue Rock</u> <u>to</u>		<u>23</u>
<u>3 miles South of Okolona</u> (distance) (direction) (Nearest Town)	<u>SAND</u> <u>to</u>		<u>300</u>
(3) Topography: <u>Flat</u> (Hilly) (Flat) (Level)	<u>Bottom</u>		<u>440</u>
(4) Purpose of Well: <u>Domestic</u> (Domestic Irrigation Municipal, Industrial, Other)			


Information upon completion of well:

- (1) Diameter 6 inches.
- (2) Total Depth 440 feet.
- (3) Water Level 107 feet below top of ground.
- (4) Cased to 23' 1", Size 6".
- (5) Screen: Size \_\_\_\_\_, Length \_\_\_\_\_.
- (6) Were any formations sealed against pollution?  
X yes, \_\_\_\_\_ no.

If YES depth of formation 23 ft

Why Surface

Drillers Remarks: 37 HP Sub.  
168 ft deep pipe

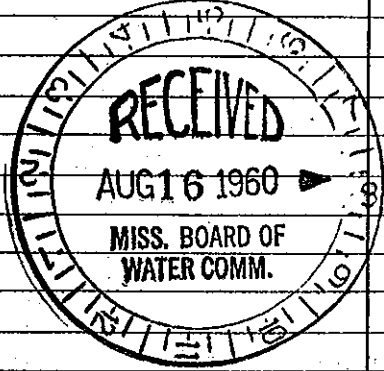

Well No  
H300

(Use Back Side)

Mail this copy to Board of Water Commissioners 429 Miss. St. Jackson, Miss