

CHICKASAW MISSISSIPPI BOARD OF WATER COMMISSIONERS

H 20 5 13E
5-16-61

WATER WELL DRILLERS LOG

H-302

Date: May 16, 1961, Driller: HERNDON WELL & SUPPLY CO.
 P. O. BOX 42 County: Chickasaw
 SHANNON, MISSISSIPPI

(1) Owner of Land: <u>Joe N. Bousard</u> (Name)	Description & Color of Materials Sand, Clay, Red Clay, Shell, etc.	Thick- ness Feet	Depth Feet
<u>Okolona, Miss.</u> (Address)	<u>Surface sand</u>		<u>0</u>
(2) Location: <u>1/4, 1/4, Sec 22 T. 135 R. 5E</u> <u>South</u> of <u>Okolona</u> , (distance) (direction) (Nearest Town)	<u>clay</u> <u>Blue shale</u> <u>Sand</u>	<u>20</u> <u>320</u>	
(3) Topography: <u>Flat</u> (Hilly) (Flat) (Level)	<u>Bottom</u>		<u>440</u>
(4) Purpose of Well: <u>House use</u> (Domestic Irrigation Municipal, Industrial, Other)			


Information upon completion of well:

- (1) Diameter 4 inches.
- (2) Total Depth 440 feet.
- (3) Water Level 100 feet below top of ground.
- (4) Cased to 23' 3", Size 4"
- (5) Screen: Size _____, Length _____.
- (6) Were any formations sealed against pollution?
✓ yes, _____ no.

If YES depth of formation 20 ft

Why Surface & sand

Drillers Remarks:

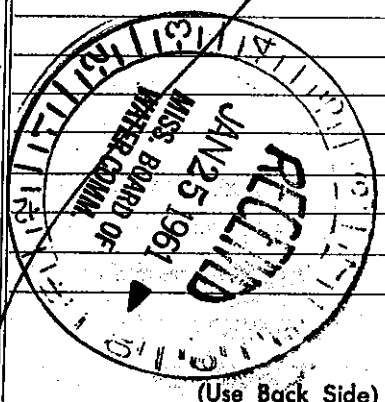

(Use Back Side)

Well No.

Mail this copy to Board of Water Commissioners 429 Miss. St. Jackson, Miss