

CHICKASAW MISSISSIPPI BOARD OF WATER COMMISSIONERS

H 21 5 13L

WATER WELL DRILLERS LOG

H CODED 1

6-7-61

Date: June 7, 1961, Driller: HERNDON WELL & SUPPLY CO. County Chickasaw

P. O. BOX 42  
SHANNON, MISSISSIPPI

(1) Owner of Land: <u>Wesley Coleman</u> (Name)	Description & Color of Materials Sand, Clay, Red Clay, Shell, etc.	Thick- ness Feet	Depth Feet
<u>Okeola, Miss.</u> (Address)	<u>Surface sand &amp; clay</u>		0
(2) Location: <u>1/4, 1/4, Sec 11 T 13 S R 5 E</u> <u>3 miles South of Okeola,</u> (distance) (direction) (Nearest Town)	<u>Blue rock</u>		10
(3) Topography: <u>Flat</u> (Hilly) (Flat) (Level)	<u>Sand</u>		320
(4) Purpose of Well: <u>Domestic</u> (Domestic Irrigation Municipal, Industrial, Other)	<u>Bottom</u>		460


Information upon completion of well:

- (1) Diameter 5 inches.
- (2) Total Depth 460 feet.
- (3) Water Level 110 feet below top of ground.
- (4) Cased to 15', Size 5".
- (5) Screen: Size     , Length     .
- (6) Were any formations sealed against pollution?  
 yes,  no.

If YES depth of formation 10'

Why bottom to stud

Drillers Remarks:     

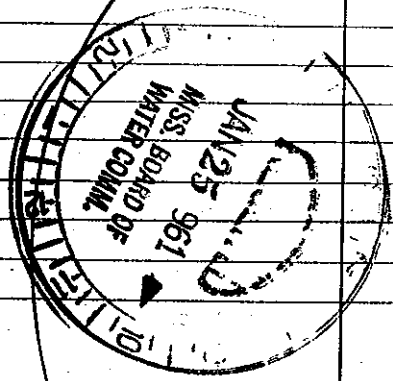

(Use Back Side)

Well No.

Mail this copy to Board of Water Commissioners 429 Miss. St. Jackson, Miss