

CHICKASAW

H 22

MISSISSIPPI BOARD OF WATER COMMISSIONERS

5 13L

CODED

1-28-62

WATER WELL DRILLERS LOG

HERNDON WELL & SUPPLY CO.

Date: Jan 28, 1962, Driller: P. J. FOX JR. County: Chickasaw
SHANNON, MISSISSIPPI (Name)

(1) Owner of Land:	Description & Color of Materials Sand, Clay, Red Clay, Shell, etc.	Thick- ness Feet	Depth Feet
Prentiss Thompson (Name) Okolona, Miss. (Address)	Surface sand & clay		0
(2) Location: 1/4, 1/4, Sec. 1 T. 13S R. 5E miles south of Okolona (distance) (direction) (Nearest Town)	Blue rock Sand		20 220
(3) Topography: Flat (Hilly) (Flat) (Level)			
(4) Purpose of Well: Domestic (Domestic Irrigation Municipal, Industrial, Other)	Bottom		340


Information upon completion of well:

- (1) Diameter 4 inches.
- (2) Total Depth 340 feet.
- (3) Water Level 80 feet below top of ground.
- (4) Cased to 221, Size 4 1/2
- (5) Screen: Size _____, Length _____
- (6) Were any formations sealed against pollution?
yes, no.

If YES depth of formation 20'

Why: Inflow & sand

Drillers Remarks:

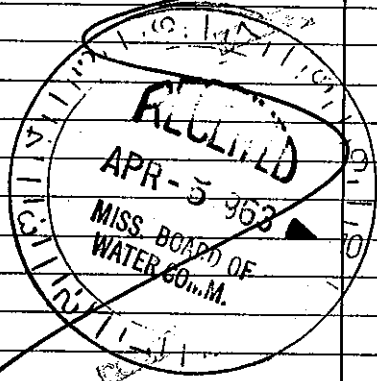

(Use Back Side)

Well No.

Mail this copy to Board of Water Commissioners 429 Miss. St. Jackson, Miss.