

CHICKASAW

MISSISSIPPI BOARD OF WATER COMMISSIONERS

H 23

5 13E

9-1-62

WATER WELL DRILLERS LOG

HERNDON WELL & SUPPLY CO.

INDEXED

Date: Sept 19 1962 Driller: SHANNON P. O. BOX 42 MISSISSIPPI County Chickasaw

(1) Owner of Land	Description & Color of Materials Sand, Clay, Red Clay, Shell, etc.	Thick- ness Feet	Depth Feet
<u>J. Q. Callahan</u> (Name) <u>Okolona, Miss.</u> (Address)	<u>Sand &amp; clay</u>	<u>0</u>	<u>0</u>
(2) Location: <u>1/4, 1/4, Sec 26 T 135 R 5E</u> <u>3</u> miles <u>NW</u> , of <u>Okolona</u> (distance) (direction) (Nearest Town)	<u>Blue sand</u>	<u>20</u>	<u>20</u>
(3) Topography: <u>Flat</u> (Hilly) (Flat) (Level)	<u>Sand</u>	<u>380</u>	<u>380</u>
(4) Purpose of Well: <u>Domestic</u> (Domestic Irrigation Municipal, Industrial, Other)	<u>Bottom</u>	<u>500</u>	<u>500</u>


Information upon completion of well:

- (1) Diameter 5 inches.
- (2) Total Depth 500 feet.
- (3) Water Level 100 feet below top of ground.
- (4) Cased to 23' 3", Size 5"
- (5) Screen: Size —, Length —
- (6) Were any formations sealed against pollution?  
— yes, — no.

If YES depth of formation 20 ft.

Why Surface & sand

Drillers Remarks:

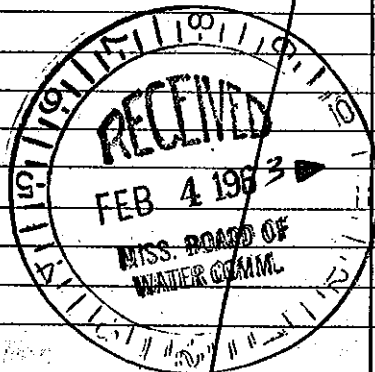

(Use Back Side)

Well No.

Mail this copy to Board of Water Commissioners 429 Miss. St. Jackson, Miss