

CHICKASAW

MISSISSIPPI BOARD OF WATER COMMISSIONERS

H 24

5 136

6-4-65

WATER WELL DRILLERS LOG

CODED

Herndon-Homan Well & Supply, Inc.

Date: June 4, 1965

Driller:

P. O. Box 42

County

SHANNON, MISSISSIPPI 38868

CHICKASAW

(1) Owner of Land:	Description & Color of Materials Sand, Clay, Red Clay, Shell, etc.	Thick- ness Feet	Depth Feet
George Moore (Name)	surface sand & clay	-	-
At Okolona, Miss. (Address)	clay	0-19	-
(2) Location: 1/4, 1/4, Sec. 1 T. 135 R. 22	blue clay	19-300	-
1 miles SE of Okolona (distance) (direction) (Nearest Town)	Sand	300-420	-
(3) Topography: Flat (Hilly) (Flat) (Level)	Bottom	420	-
(4) Purpose of Well: Domestic (Domestic Irrigation Municipal, Industrial, Other)			


Information upon completion of well:

- (1) Diameter 5 inches.
- (2) Total Depth 420 feet.
- (3) Water Level 90 feet below top of ground.
- (4) Cased to 21' 2", Size 5"
- (5) Screen: Size , Length
- (6) Were any formations sealed against pollution?
 yes, no.

If YES depth of formation 19

Why surface & sand

Drillers Remarks:

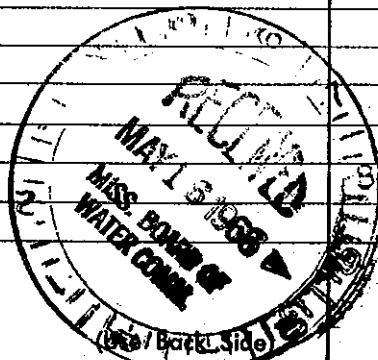

Well No.

Mail this copy to Board of Water Commissioners 429 Miss. St. Jackson, Miss.