

Chickasaw

H 26

3 13E

7-66

MISSISSIPPI BOARD OF WATER COMMISSIONERS

CODED

WATER WELL DRILLERS LOG

CODED

Herndon-Homan Well & Supply, Inc.

Date: July 16, 1966, Driller:

P. O. Box 42

County Chickasaw

(When well drilled)

M.E. Nabors

SHANNON, MISSISSIPPI 38868

(Name)

(Where well is located)

(1) Owner of Land: M.E. Nabors

(Name)

Description & Color of Materials
Sand, Clay, Red Clay, Shell, etc.

Thick-
ness
Feet

Depth
Feet

At Okolona, Miss.

(Address)

Surface clay

0-18

(2) Locations: SE 1/4, NW 1/4, Sec. 26 T. 35 N. R. 5 E

Blue clay

18-360

Sand

360-500

Bottom

500

3 miles S of Okolona

(distance)

(direction)

(Nearest Town)

(3) Topography: Flat level

(Hilly)

(Flat)

(Level)

(4) Purpose of Well: Domestic

(Domestic Irrigation
Municipal, Industrial, Other)

Information upon completion of well:

(1) Diameter 5 inches.

(2) Total Depth 500 feet.

(3) Water Level 113' feet below top of ground.

(4) Cased to 21 1/2", Size 5 1/4

(5) Screen: Size none, Length -

(6) Were any formations sealed against pollution?

Yes, no.

If YES depth of formation 18'


Why Surface & Sand

Drillers Remarks:

Yield in gpm: 10 gpm

Size pump: 3/4 HP Sub.

Type power: Electric

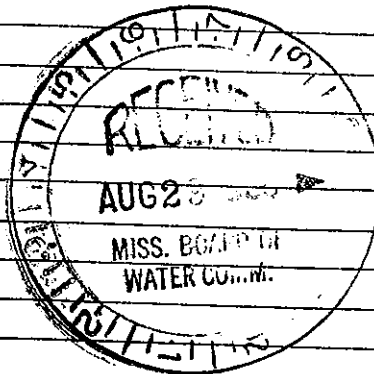

Mail this copy to Board of Water Commissioners 429 Miss. St. Jackson, Miss.