

Chickasaw
H 27
4-67

3 13E
MISSISSIPPI
BOARD OF WATER COMMISSIONERS
416 North State Street
Jackson, Mississippi 39201

CODED

WATER WELL DRILLERS LOG

Herndon-Homan Well & Supply, Inc.

4-26 1967
date well completed

P. O. Box 42

SHANNON, MISSISSIPPI 38808

Chickasaw
county well located

LANDOWNER:

Ambrose Kieck
Okolona, Miss.
(mailing address)

description of formations encountered

description of formations encountered	from	to
Surface sand & clay	0	12
Blue clay	12	30
Red clay	30	45
Bottom	45	

WELL LOCATION:


sec. 14 T. 13 N. R. 5 E. S. 1 W.
3 miles SW of Okolona
(distance) (direction) (nearest town)

WELL PURPOSE:

Home
(home, irrigation, municipal, industrial)

WELL COMPLETION DATA:

- (1) diameter (inches) 5"
- (2) total depth (feet) 450'
- (3) static water level (feet) _____ below/above top of ground.
- (4) casing: steel, 16' 7" (material), (depth)
5" (size) if telescope see back.
- (5) screen: wire, (length), (depth to top)
(size), (material)
- (6) pump: 1/2 (HP), 5 (yield gpm)
Electric (type power)
- (7) electric log: no (yes or no)
(organization running log)
- (8) how well bottom plugged: open

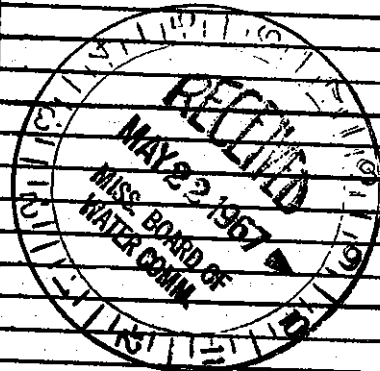

DRILLERS REMARKS: