

CHICKASAW MISSISSIPPI BOARD OF WATER COMMISSIONERS

K 16

4 13E

K 300

WATER WELL DRILLERS LOG

7-20-60

Date: 7-20, 1960, Driller: R. S. Aubby County: Chickasaw

(Name)

(1) Owner of Land:	Description & Color of Materials Sand, Clay, Red Clay, Shell, etc.	Thick- ness Feet	Depth Feet
<u>J. D. Doss</u> (Name)	<u>Sand & red clay</u>	<u>20'</u>	<u>20</u>
<u>Honaton Miss</u> (Address)	<u>Blue mudstone</u>	<u>20'</u>	<u>20</u>
(2) Location: <u>NE 1/4</u> , <u>1/4</u> , Sec. <u>26</u> T <u>14R</u> S <u>3E</u>	<u>Black shale</u>	<u>40'</u>	<u>40</u>
<u>6</u> miles <u>South</u> of <u>Honaton</u> (distance) (direction) (Nearest Town)	<u>Top Blue Rock</u>	<u>84'</u>	<u>84</u>
(3) Topography: <u>X</u> (Hilly) (Flat) (Level)	<u>Blue Rock</u>	<u>462'</u>	<u>462'</u>
(4) Purpose of Well: <u>Domestic</u> (Domestic Irrigation Municipal, Industrial, Other)	<u>Hard sand Rock</u>	<u>3'</u>	<u>3'</u>
	<u>Blue Rock</u>	<u>2'</u>	<u>2'</u>
	<u>Hard flint Rock</u>	<u>4'</u>	<u>4'</u>
	<u>Blue Rock & shell</u>	<u>152'</u>	<u>152</u>
	<u>Other land</u>	<u>100'</u>	<u>100'</u>

Information upon completion of well:

- (1) Diameter 4" inches.
- (2) Total Depth 807 feet.
- (3) Water Level 110 feet below top of ground.
- (4) Cased to 84', Size 4"
- (5) Screen: Size 0, Length 0
- (6) Were any formations sealed against pollution?
X yes, no.


If YES depth of formation 60"

Why Surface water

Drillers Remarks: Time & Draw

in water

Draw down 25'

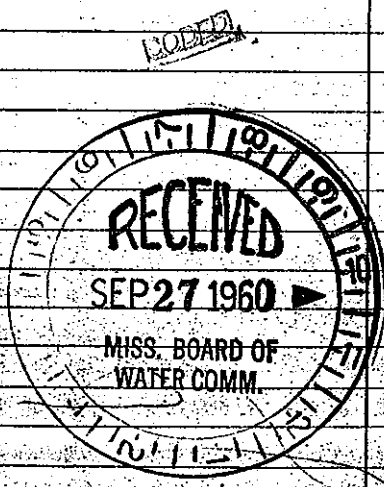

Well No. K 300

(Use Back Side)

Mail this copy to Board of Water Commissioners 429 Miss. St. Jackson, Miss.