

Chickasaw
K 40 3 13E

4-66 MISSISSIPPI BOARD OF WATER COMMISSIONERS

CODED

WATER WELL DRILLERS LOG

Date: April 2, 1966, Driller: Herndon-Homan Well & Supply, Inc.
(When well drilled) P. O. Box 62 County Chickasaw
SIANNON, MISSISSIPPI 38869 (Where well is located)

(1) Owner of Land: CURTIS CROSSWART
(Name)
Houston, Miss.
(Address)

(2) Location: SW 1/4 NE 1/4, Sec. 6 T143E
1/4 miles W, of Houston
(distance) (direction) (Nearest Town)

(3) Topography: flat
(Hilly) (Flat) (Level)

(4) Purpose of Well: BUSINESS
(Domestic Irrigation, Municipal, Industrial, Other)

Description & Color of Materials Sand, Clay, Red Clay, Shell, etc.	Thick- ness Feet	Depth Feet
<u>surface sand & clay</u>	<u>20</u>	<u>20</u>
<u>blue clay</u>	<u>30</u>	<u>100</u>
<u>Sand</u>	<u>120</u>	<u>220</u>
<u>Bottom</u>	<u>220</u>	

Information upon completion of well:

(1) Diameter 4 inches.

(2) Total Depth 220 feet.

(3) Water Level 50 feet below top of ground.

(4) Cased to 25' 6", Size 4"

(5) Screen: Size none, Length _____

(6) Were any formations sealed against pollution?
 yes, _____ no.

If YES depth of formation 20'


Why surface & sand

Drillers Remarks: _____

Yield in gpm: 0

Size pump: 3/4 HP

Type power: electric

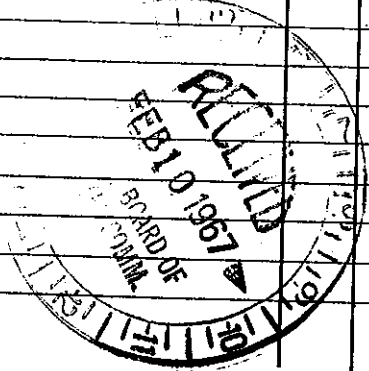

Mail this copy to Board of Water Commissioners 429 Miss. St. Jackson, Miss.