

Chickasaw

MISSISSIPPI

K
10-66 2501

WATER WELL DRILLERS LOG

Date: 10-19, 1966, Driller: R. S. Ashby County: Chickasaw

(Name)

(1) Owner of Land: <u>D.W. Baird</u> (Name)	Description & Color of Materials Sand, Clay, Red Clay, Shell, etc.	Thick- ness Feet	Depth Feet
<u>Houston Miss</u> (Address)	<u>This is the first well</u>		
(2) Location: <u>1/4 Sec. 04 T4 R3</u> <u>2 miles east</u> of <u>Houston</u> (distance) (direction) (Nearest Town) <u>old H4 way - 8 east</u>	<u>my Rig has drilled</u>		
(3) Topography: <u>X</u> (Hilly) (Flat) (Level)	<u>in 1966 not being able</u>		
(4) Purpose of Well: <u>Home use</u> (Domestic Irrigation Municipal, Industrial, Other)	<u>to be at rig & do not</u>		
	<u>have a complete log</u>		
	<u>of well. the first water</u>		
	<u>bearing sand was topped</u>		
	<u>at 126' was forty feet in</u>		
	<u>depth.</u>		
	<u>the new sand</u>		
	<u>topped at 843' drilled</u>		
	<u>completed through at</u>		
	<u>987' or 144' of sand</u>		
	<u>the well is pumping</u>		
	<u>455 gpm per min</u>		
	<u>with about 20 foot draw</u>		
	<u>down.</u>		
	<u>This will be the only</u>		
	<u>well I will drill</u>		
	<u>this year</u>		
	<u>This well has 1 1/2 HP</u>		
	<u>motor submersed at</u>		
	<u>210 feet</u>		

Information upon completion of well:


- (1) Diameter 4 inches.
- (2) Total Depth 987 feet.
- (3) Water Level 160 feet below top of ground.
- (4) Cased to 2 1/2" 4", Size 4"
- (5) Screen: Size 2" pipe, Length 714'
100' perforated.
- (6) Were any formations sealed against pollution?
X yes, no.

If YES depth of formation 126'

Why Hard Water

Drillers Remarks: 126' to first sand

Water hard, casing set
below sand to cut out

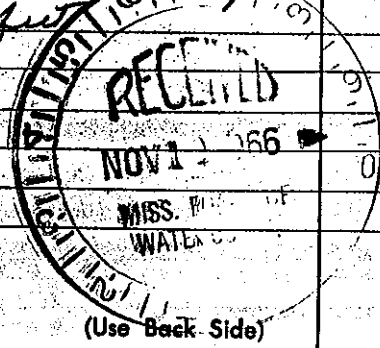

987
Well No.

(Use Back Side)

Retain this copy for your office files.