

CHICKASAW MISSISSIPPI BOARD OF WATER COMMISSIONERS

L 23 5 13E

CODED

WATER WELL DRILLERS LOG

2-25-63

Date: Feb 25, 1963, Driller: HERNDON WELL & SUPPLY CO. County: Chickasaw

P.O. BOX 42  
SHANNON, MISSISSIPPI

	Description & Color of Materials Sand, Clay, Red Clay, Shell, etc.	Thick- ness Feet	Depth Feet
(1) Owner of Land: <u>J H Cousid</u> (Name)	<u>surface sand</u>		0
<u>Buckra Vista, Miss.</u> (Address)	<u>to clay</u>		
(2) Location: <u>1/4, 1/4, Sec 24 T 14S R 4E</u>	<u>red</u>		15
<u>1 1/2</u> miles <u>N</u> , of <u>Treblac</u> (distance) (direction) (Nearest Town)	<u>8</u>		
(3) Topography: <u>Flat</u> (Hilly) (Flat) (Level)	<u>500</u>		500
(4) Purpose of Well: <u>Domestic</u> (Domestic Irrigation Municipal, Industrial, Other)	<u>Bottom</u>		620


Information upon completion of well:

- (1) Diameter 4 inches.
- (2) Total Depth 620 feet.
- (3) Water Level 115 feet below top of ground.
- (4) Cased to 20' 9", Size 4"
- (5) Screen: Size     , Length
- (6) Were any formations sealed against pollution?  
 yes,  no.

If YES depth of formation 15 ft.

Why surface sand

Drillers Remarks:

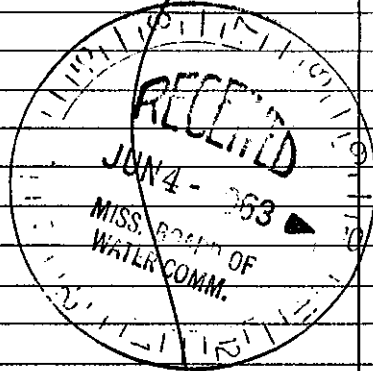

Well No.

(Use Back Side)

Mail this copy to Board of Water Commissioners 429 Miss. St. Jackson, Miss