

CHICKASAW MISSISSIPPI BOARD OF WATER COMMISSIONERS

L 24 5 13E

8-26-63 WATER WELL DRILLERS LOG

CODED

Date: 5/26, 1963, Driller: HERNDON WELL & SUPPLY CO. P.O. BOX 22 County: Chickasaw
SELANNO (Name) MISSISSIPPI

(1) Owner of Land:	Description & Color of Materials Sand, Clay, Red Clay, Shell, etc.	Thick- ness Feet	Depth Feet
(Name) Gay Arnold (Address) Buna Vista, Miss	surface sand & clay		0
(2) Location: 1/4, 1/4, Sec. 14 5 T 24 R 4 E 1/2 miles N of Buna Vista (distance) (direction) (Nearest Town)	Blue sand	5	23
(3) Topography: Flat (Hilly) (Flat) (Level)	sand	8	520
(4) Purpose of Well: Flat (Domestic Irrigation Municipal, Industrial, Other)	Bottom		660


Information upon completion of well:

- (1) Diameter 4 inches.
- (2) Total Depth 660 feet.
- (3) Water Level 150 feet below top of ground.
- (4) Cased to 26' 6" Size 4"
- (5) Screen: Size 2, Length —
- (6) Were any formations sealed against pollution?
yes, no.

If YES depth of formation 23'

Why surface & sand

Drillers Remarks:

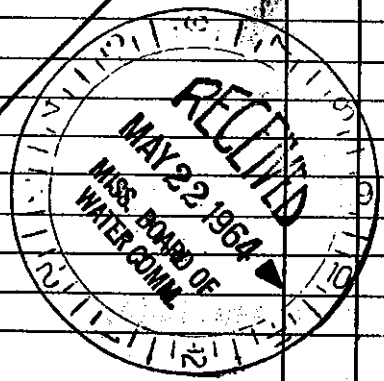

(Use Back Side)

Well No.

Mail this copy to Board of Water Commissioners 429 Miss. St. Jackson, Miss.