

Chickasaw
L 25 3 13E
4-66

MISSISSIPPI BOARD OF WATER COMMISSIONERS

CODED

WATER WELL DRILLERS LOG

CODED

Date: April 14, 1966, Driller: Herndon-Homan Well & Supply, Inc.
(When well drilled) (Name) (Where well is located)
P. O. Box 42, County Chickasaw
SHANNON, MISSISSIPPI 38888

(1) Owner of Land:	Description & Color of Materials	Thick-ness Feet	Depth Feet
<u>H. L. Parchman</u> (Name) <u>Bama Vista, Miss.</u> (Address)	<u>surface sand & clay</u>	<u>0</u>	<u>20</u>
	<u>blue clay</u>	<u>20</u>	<u>580</u>
(2) Location: <u>NE 1/4, SW 1/4, Sec 12, T 14 S, R 4 W</u>	<u>both</u>	<u>580</u>	<u>700</u>
<u>1/2</u> miles <u>S</u> , of <u>Bama Vista</u> (distance) (direction) (Nearest Town)		<u>700</u>	
(3) Topography: <u>flat</u> (Hilly) (Flat) (Level)			
(4) Purpose of Well: <u>Home</u> (Domestic Irrigation, Municipal, Industrial, Other)			

Information upon completion of well:

(1) Diameter 4 inches.

(2) Total Depth 700 feet.

(3) Water Level 190 feet below top of ground.

(4) Cased to 314', Size 4"
399' 2"

(5) Screen: Size None, Length _____

(6) Were any formations sealed against pollution?
 yes, no.

If YES depth of formation 20'


Why Surface & same

Drillers Remarks: _____

Yield in gpm: 6

Size pump: 3/4 HP

Type power: Electric

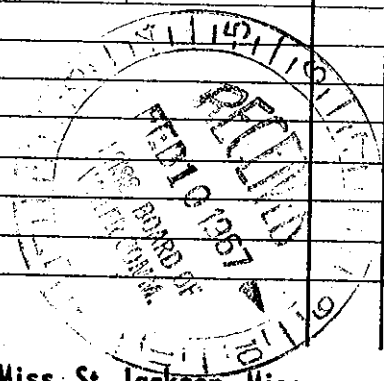

Mail this copy to Board of Water Commissioners 429 Miss. St. Jackson, Miss.