

Chickasaw
L 27 3 13E

7-66

MISSISSIPPI BOARD OF WATER COMMISSIONERS
CODES

WATER WELL DRILLERS LOG

Date: July 8, 1966, Driller: Hendon Homan Well & Supply, Inc.
(When well drilled) P. O. Box 42 County Chickasaw
SHANNON, MISSISSIPPI 38779 (Where well is located)

(1) Owner of Land: <u>James P. Brown</u> <small>(Name)</small>	Description & Color of Materials Sand, Clay, Red Clay, Shell, etc.	Thick- ness Feet	Depth Feet
<u>Box 3 Houston, Miss.</u> <small>(Address)</small>	<u>surface sand & clay</u>	<u>0</u>	<u>18</u>
(2) Location: <u>SW 1/4, SW 1/4, Sec. 26 T45R4E</u> <u>1 1/2 miles SW of Houston</u> <small>(distance) (direction) (Nearest Town)</small>	<u>blue clay</u>	<u>18</u>	<u>620</u>
(3) Topography: <u>Flat</u> <small>(Hilly) (Flat) (Level)</small>	<u>sand</u>	<u>620</u>	<u>740</u>
(4) Purpose of Well: <u>Domestic</u> <small>(Domestic Irrigation Municipal, Industrial, Other)</small>	<u>bottom</u>	<u>740</u>	

Information upon completion of well:

(1) Diameter 5 inches.

(2) Total Depth 740 feet.

(3) Water Level 90' feet below top of ground.

(4) Cased to 21'3", Size 5"

(5) Screen: Size —, Length —

(6) Were any formations sealed against pollution?
 yes, no.

If YES depth of formation 18'


Why surface sand

Drillers Remarks: _____

Yield in gpm: 6 gpm

Size pump: 3/4 HP Sub.

Type power: Electric

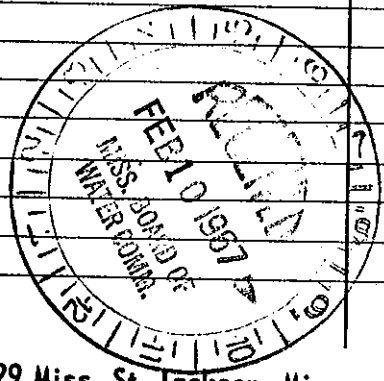

Mail this copy to Board of Water Commissioners 429 Miss. St. Jackson, Miss.