

C HICKASAW

MISSISSIPPI BOARD OF WATER COMMISSIONERS

M 19 5 13E

CODED
CODED

9-25-62 WATER WELL DRILLERS LOG

Date: Sept 25, 1962, Driller: HERNDON WELL & SUPPLY CO.
P. O. BOX 42 County Chickasaw
SLANNON, MISSISSIPPI


(1) Owner of Land:	Description & Color of Materials Sand, Clay, Red Clay, Shell, etc.	Thick- ness Feet	Depth Feet
<u>A.G. Kahl</u> (Name) <u>Gibson, Miss</u> (Address)	<u>sand & clay</u>		<u>0</u>
(2) Location: <u>24 145</u> <u>RSE</u> <u>1 1/2</u> miles <u>NW</u> of <u>Gibson</u> (distance) (direction) (Nearest Town)	<u>Blue water</u>	<u>8</u>	<u>12</u>
(3) Topography: <u>level</u> (Hilly) (Flat) (Level)	<u>sand</u>	<u>8</u>	<u>300</u>
(4) Purpose of Well: <u>Domestic</u> (Domestic Irrigation Municipal, Industrial, Other)	<u>Bottom</u>	<u>8</u>	<u>420</u>

Information upon completion of well:

- (1) Diameter 5 inches.
- (2) Total Depth 420 feet.
- (3) Water Level 80 feet below top of ground.
- (4) Cased to 16'6", Size 5".
- (5) Screen: Size , Length .
- (6) Were any formations sealed against pollution?
✓ yes, no.

If YES depth of formation 12'Why perform & seal

Drillers Remarks:

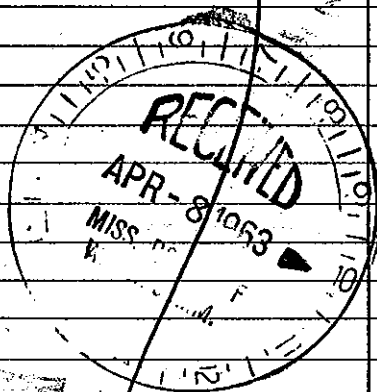

We