

M 20

5 13E

## WATER WELL DRILLERS LOG

HERNDON WELL &amp; SUPPLY CO.

2-8-63

Date: Feb. 7, 1963

Driller: SHANNON, MISSISSIPPI

P. O. BOX 42

COUNTY CODED  
CHICKASAW

| (1) Owner of Land:  | Description & Color of Materials<br>Sand, Clay, Red Clay, Shell, etc. | Thick-<br>ness<br>Feet | Depth<br>Feet |
|---|---|------------------------|---------------|
| Marshall Foster<br>(Name)<br>Egypt Miss.<br>(Address)   | surface sand<br>& clay<br>&   |                        | 0             |
| (2) Location: 1/4, 1/4, Sec. 3 T. 145 R. 25<br>2 miles W, of Egypt<br>(distance) (direction) (Nearest Town) | Blue sand<br>&  |                        | 18            |
| (3) Topography: level<br>(Hilly) (Flat) (Level)   | sand<br>&   |                        | 340           |
| (4) Purpose of Well: Domestic<br>(Domestic Irrigation<br>Municipal, Industrial, Other)                      | Bottom  |                        | 460           |


## Information upon completion of well:

- (1) Diameter 4 inches.
- (2) Total Depth 460 feet.
- (3) Water Level 80 feet below top of ground.
- (4) Cased to 20' 8", Size 4"
- (5) Screen: Size \_\_\_\_\_, Length \_\_\_\_\_
- (6) Were any formations sealed against pollution?  
yes, no.

If YES depth of formation 18'

Why surface &amp; sand

Drillers Remarks:

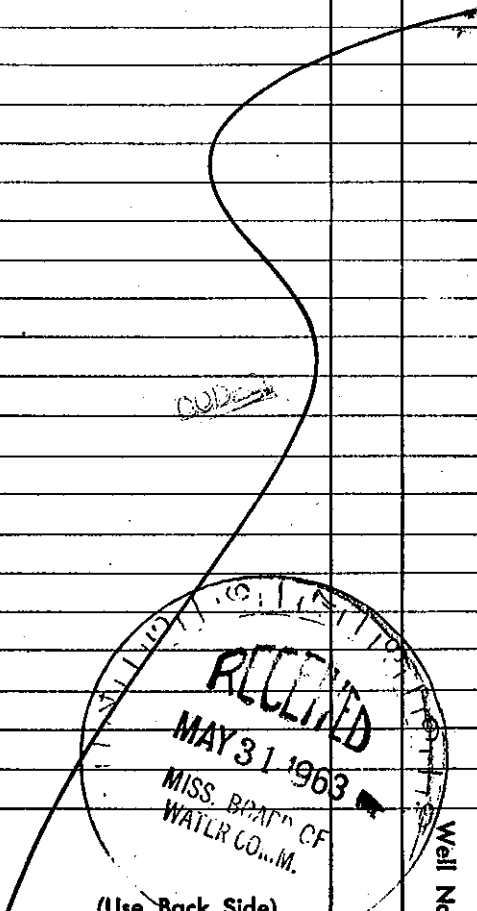

(Use Back Side)

Well No