

MISSISSIPPI DEPARTMENT OF ENVIRONMENTAL QUALITY
Office of Land and Water Resources
P. O. Box 10631
Jackson, MS 39289-0631
WATER WELL DRILLERS LOG

COUNTY WELL LOCATED Chickasaw	
WELL NUMBER 2	CODED
M-54	
DATE WELL COMPLETED 8-18-2002	

PERMIT NUMBER MSGW 15548
NAME OF DRILLING FIRM PARIS + PARKS WELL SERVICE
HOUSTON, MS 38851

NAME & MAILING ADDRESS OF LANDOWNER C. C. M. WATER ASSN. 714 CR 179 Okolona, MS 38860
Latitude: Longitude:
WELL LOCATION SEC TOWNSHIP RANGE 23 14 N 5 E
DISTANCE DIRECTION NEAREST TOWN 12 Miles WEST of ABERDEEN
OTHER LANDMARK
WELL PURPOSE: Home, Irrigation, Municipal, Industrial, Fish Pond, etc. WATER SYSTEM

PUMP DATA
PUMP TYPE (Circle One): Submersible Turbine, Jet, Flowing Well, Other (Describe)
POWER TYPE (Circle One): Electric, Tractor, Diesel, Gasoline, Butane, Other (Describe) H/P 20

DESCRIPTION OF FORMATIONS ENCOUNTERED	FROM	TO

RECEIVED
OCT 17 2002
BY: OLWR

WELL DATA
Well Depth Casing Diameter (In.) Casing Length (Fl.) 430 10 365
Type of Casing Hole Depth Depth to Static Water Level STEEL SDS
TYPE OF COMPLETION: (Circle One or More): Gravel Packed, Underreamed, Telescoped, Natural Development, Open Hole, Other (Describe)
WELL GROUTED TO A DEPTH OF 365 FEET Type Grout (circle one): Cement, Bentonite, or Mix

SCREEN DATA
Diameter - inches Length - Feet Slot Size - Inches 4 60 .016
Screen Type Depth to Bottom - Feet SS 430


Top of Lap Pipe or Reduction in Casing 310 FEET IF TELESCOPED OR MORE THAN ONE SCREEN: USE BACK PAGE

I certify that the well was drilled, constructed and completed in accordance with all applicable Requirements of the Mississippi Department of Environmental Quality and/or the Mississippi Department of Health regulations and state laws.

Rayburn Park 0414
Signature of Licensed Driller and License No.

10-8-2002
Date

If well telescopes please sketch and show depths.

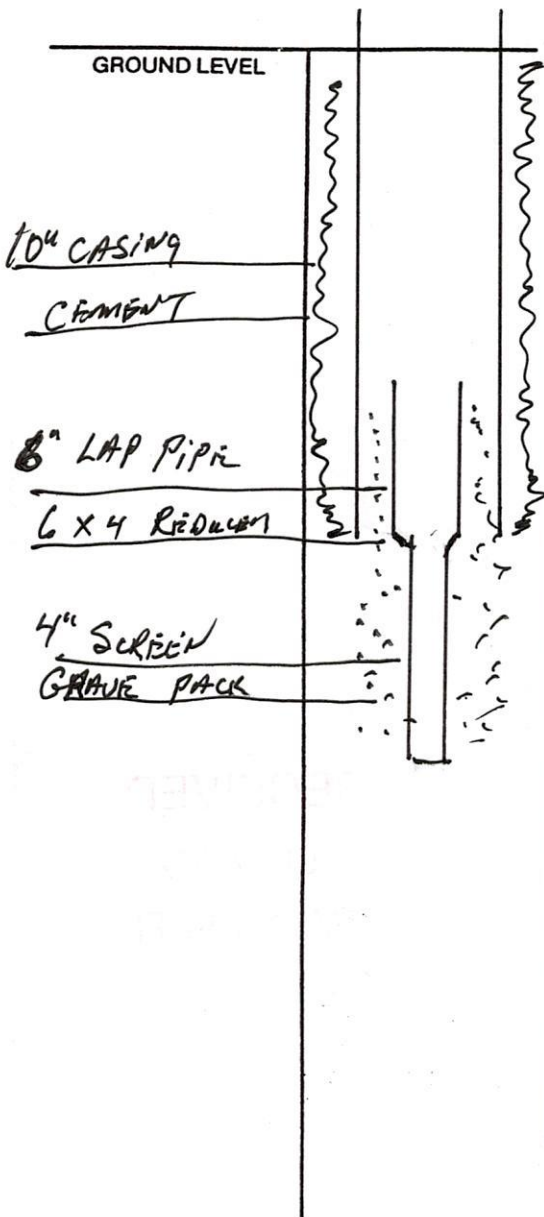

	X		

SECTION _____

Please indicate well location X.

Pump Capacity (GPM)	No. of Stages	Setting Depth	FT.
150	11	240	

PUMP TEST

Well yielded 201 GPM with
 a drawdown of 78 ft.
 after 25 hours of pumping

LOG DATA

TYPE OF LOG RUN (Circle One): No Log Run, Electric, Gamma Ray, Density, Sonic, Neutron, Other (Describe) MSGS

Name of Organization Running Log

MSGS

GEOLOGIC DATA (Office Use Only)

Surface Elev.	Geologic Unit	Unit Thickness	Depth to Top
Subs. SWL	Date	Analysis	Aquifer Test

Driller's Remarks

If more than one screen, show location of each on sketch.