

Chickasaw 3 13E

N. 23 MISSISSIPPI BOARD OF WATER COMMISSIONERS

9-66

WATER WELL DRILLERS LOG

CODED

Herndon-Homan Well & Supply, Inc.

Date: Sept 27, 1966, Driller: P. O. Box 42 County: Chickasaw
SHANNON, MISSISSIPPI 38868 (Where well is located)

(1) Owner of Land: <u>Sebro Chandler</u> (Name)	Description & Color of Materials Sand, Clay, Red Clay, Shell, etc.	Thick- ness Feet	Depth Feet
<u>Hoaston, Miss.</u> (Address)	<u>surface sand & clay</u>	<u>28</u>	<u>28</u>
(2) Location: <u>NE 1/4 SW 1/4, Sec. 12, T15R2, S E</u>	<u>Blue clay</u>	<u>72</u>	<u>100</u>
<u>2</u> miles <u>N</u> , of <u>Woodland</u> (distance) (direction) (Nearest Town)	<u>Sand</u>	<u>10</u>	<u>220</u>
(3) Topography: <u>Flat</u> (Hilly) (Flat) (Level)	<u>Silt</u>		
(4) Purpose of Well: <u>Home</u> (Domestic Irrigation Municipal, Industrial, Other)			

Information upon completion of well:

- (1) Diameter 5 inches.
- (2) Total Depth 220 feet.
- (3) Water Level 65 feet below top of ground.
- (4) Cased to 32', Size 5"
- (5) Screen: Size none Length _____
- (6) Were any formations sealed against pollution?
 yes, _____ no.

If YES depth of formation 28'


Why surface sand

Drillers Remarks: _____

Yield in gpm: 5

Size pump: 3/4

Type power: electric

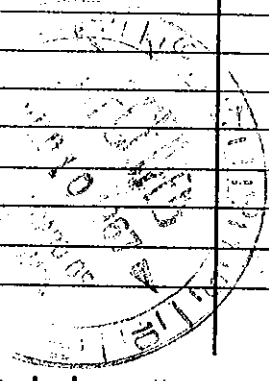

Mail this copy to Board of Water Commissioners 429 Miss. St. Jackson, Miss.