

CHICKASAW

MISSISSIPPI BOARD OF WATER COMMISSIONERS

N 2000

8-10-61

WATER WELL DRILLERS LOG

HERNDON WELL & SUPPLY CO.

Date: 9/10, 1962, Driller: P. O. BOX 42 County Chickasaw  
SHANNON, MISSISSIPPI

(1) Owner of Land: <u>Louis B. Hill</u> (Name)	Description & Color of Materials Sand, Clay, Red Clay, Shell, etc.	Thick- ness Feet	Depth Feet
<u>Woodland, Miss</u> (Address)	<u>Surface sand &amp; clay</u>		0
(2) Location: <u>1/4, 1/4, Sec. 2 T. 15S R. 1E</u>	<u>Open rock</u>	8	380
<u>1</u> miles <u>E</u> of <u>Atlanta</u> (distance) (direction) (Nearest Town)	<u>sand</u>	8	1100
(3) Topography: <u>Hills</u> (Hilly) (Flat) (Level)	<u>Bottom</u>	8	1260
(4) Purpose of Well: <u>Domestic</u> (Domestic Irrigation Municipal, Industrial, Other)			


Information upon completion of well:

- (1) Diameter 4 inches.
- (2) Total Depth 1260 feet.
- (3) Water Level 150 feet below top of ground.
- (4) Cased to 391', Size 4"  
382', Size 2"
- (5) Screen: Size     , Length
- (6) Were any formations sealed against pollution?  
 yes,  no.

If YES depth of formation     

Why surface sand

Drillers Remarks:     

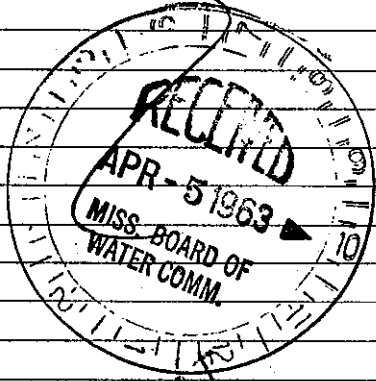

CANNOT LOCATE  
JES

Well No.

(Use Back Side)

this copy to Board of Water Commissioners 429 Miss. St. Jackson, Miss.