

3 13 E

CHICKASAW  
Ø 7  
12-67

MISSISSIPPI  
BOARD OF WATER COMMISSIONERS  
416 North State Street  
Jackson, Mississippi 39201

WATER WELL DRILLERS LOG

12/28/67 date well completed  
Horton-Roman Well & Supply, Inc. (Chickasaw)  
Box 12  
Shannon, Mississippi 38868 county well located


LANDOWNER:  
Bill Johnson  
Houston Miss.  
(mailing address)

WELL LOCATION:  
sec. 22 T 15 S R 3 E  
1/2 miles E of Sparta  
(distance) (direction) (nearest town)

WELL PURPOSE:  
Home  
(home, irrigation, municipal, industrial)

- WELL COMPLETION DATA:
- (1) diameter (inches) 4"
  - (2) total depth (feet) 880'
  - (3) static water level (feet) 50' below top of ground.
  - (4) casing Steel 286' (material) (depth)  
2" If telescope see back.  
(size)
  - (5) screen 21' 459' (length) (depth to top)  
2" 550d pipe (size) (material)
  - (6) pump 3/4 HP 5 (yield gpm)  
electric (type power) (See well log #6 Bill Johnson E-log # 24)
  - (7) electric log NO (yes or no)  
Fried by state (organization running log)
  - (8) how well bottom plugged B/Wash

description of formations encountered	from	to
uniform sand	0	100
Blue clay		
Blue clay sand		
STONES	100	185
Blue clay		
White clay	185	160
Sand	260	880
Bedrock	880	

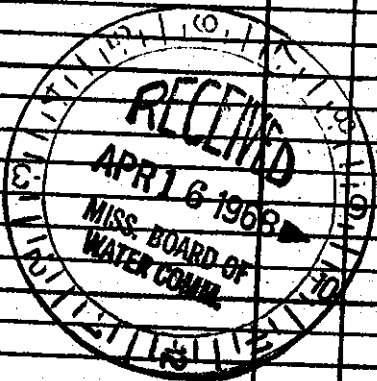

DRILLERS REMARKS: