

CHICKASAW

φ 2000

5-66

MISSISSIPPI BOARD OF WATER COMMISSIONERS

WATER WELL DRILLERS LOG

Date: May, 1966, Driller: Sam Smith County Chick.
(When well drilled) (Name) (Where well is located)


(1) Owner of Land:	Description & Color of Materials Sand, Clay, Red Clay, Shell, etc.	Thick- ness Feet	Depth Feet
<u>Bob Vaughn</u> (Name) <u>Houston, Miss</u> (Address)	<u>0-40 Red clay + sd.</u>		
(2) Location: <u>1/4, SE 1/4, Sec. 10 T15R3</u>	<u>40-100-Blue clay</u>		
<u>6</u> miles <u>South</u> , of <u>Houston</u> (distance) (direction) (Nearest Town)	<u>100-200-Blue clay + shale</u>		
(3) Topography: <input checked="" type="checkbox"/> (Hilly) <input type="checkbox"/> (Flat) <input type="checkbox"/> (Level)	<u>200-250 Blue clay</u>		
(4) Purpose of Well: <u>Domestic</u> (Domestic Irrigation Municipal, Industrial, Other)	<u>250-275 Selma chalk</u>		
	<u>275-300 Blue clay</u>		
	<u>300-325 Blue clay</u>		
	<u>325-350 Blue clay</u>		
	<u>350-375 Blue clay</u>		
	<u>375-400 Blue clay</u>		
	<u>400-425 Blue clay</u>		
	<u>425-450 Blue clay</u>		
	<u>450-475 Blue clay</u>		
	<u>475-500 Blue clay</u>		
	<u>500-525 Blue clay</u>		
	<u>525-550 Blue clay</u>		
	<u>550-575 Blue clay</u>		
	<u>575-600 Blue clay</u>		
	<u>600-625 Blue clay</u>		
	<u>625-650 Blue clay</u>		
	<u>650-675 Blue clay</u>		
	<u>675-700 Blue clay</u>		
	<u>700-725 Blue clay</u>		
	<u>725-750 Blue clay</u>		
	<u>750-775 Blue clay</u>		
	<u>775-800 Blue clay</u>		
	<u>800-825 Blue clay</u>		
	<u>825-850 Blue clay</u>		
	<u>850-875 Blue clay</u>		
	<u>875-900 Blue clay</u>		
	<u>900-925 Blue clay</u>		
	<u>925-950 Blue clay</u>		
	<u>950-975 Blue clay</u>		
	<u>975-1000 Blue clay</u>		

Information upon completion of well:

- (1) Diameter 4 inches.
- (2) Total Depth 1000 feet.
- (3) Water Level 100 feet below top of ground.
- (4) Cased to 315, Size 4
- (5) Screen: Size 2", Length 63'
- (6) Were any formations sealed against pollution?
 yes, no.

If YES depth of formation 0-80
Why Wimetown Form.

Drillers Remarks:
Yield in gpm: 12
Size pump: 3/4 h.p.
Type power: Sub.

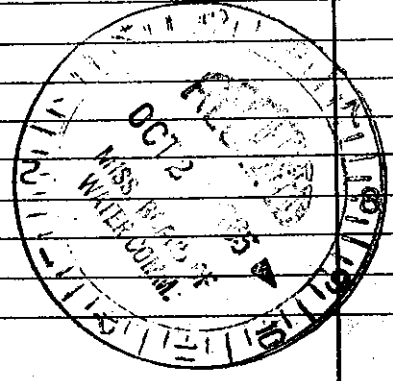

Retain this copy for your office files.