

CHOCTAW

MISSISSIPPI BOARD OF WATER COMMISSIONERS

A 8


9-5-61

WATER WELL DRILLERS LOG

Handwritten: R-301
CODED

Date: 9/5/61, 19___, Driller: L. K. Merrett County: CHOCTAW
(Name)

(1) Owner of Land:	Description & Color of Materials Sand, Clay, Red Clay, Shell, etc.	Thick- ness Feet	Depth Feet
Robert Lindsey (Name) Loupina Miss (Address)	Top Purple clay	0	10
29 19 10 (Address)	White clay	10	16
(2) Location: 1/4, 29 19 10, T R	Soft blue clay	16	26
7 miles SW of Loupina (distance) (direction) (Nearest Town)	Soft blue clay	26	30
(3) Topography: <input checked="" type="checkbox"/> (Hilly) <input type="checkbox"/> (Flat) <input type="checkbox"/> (Level)	Hard Lignite	30	34
(4) Purpose of Well: Domestic (Domestic Irrigation, Municipal, Industrial, Other)	Hard green clay	34	42
Information upon completion of well:	Soft grey clay - trace	42	57
(1) Diameter 2 inches.	1/2 Rubber band		
(2) Total Depth 230 feet.	Hard grey clay	55	65
(3) Water Level 74 feet below top of ground.	Hard Lignite	65	71
(4) Cased to 147, Size 2	Soft clay - fine grey sand	71	88
(5) Screen: Size open, Length	Hard Lignite	88	92
(6) Were any formations sealed against pollution?	Soft grey clay	92	100
yes, no.	Med. Hard grey clay	100	106
If YES depth of formation Shale Tops	Soft grey clay	106	118
Why at 147 - to prevent	Hard grey clay	118	136
Drillers Remarks: Hole falling below	Soft grey clay	136	140
end of open pipe -	Med. Hard Clay - Trace	140	164
	Shale		
	Shale, fine blue sand & clay	164	224
	Hard blue clay	224	230

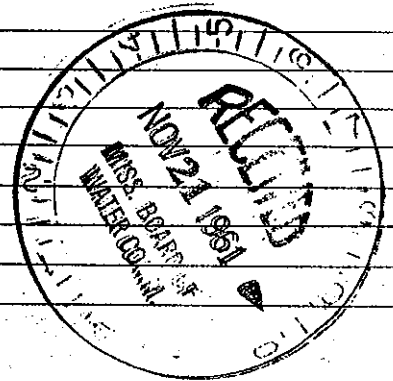

(Use Back Side)

Well No.

Mail this copy to Board of Water Commissioners 429 Miss. St. Jackson, Miss.