

BOARD OF WATER COMMISSIONERS

WATER WELL DRILLERS LOG

1-20-61

CODED

Date: Jan 20 1961, Driller: Biley Drilling Co County: Washington
(Name)

(1) Owner of Land:	Description & Color of Materials Sand, Clay, Red Clay, Shell, etc.	Thick- ness Feet	Depth Feet
<u>Town of Mathiston</u> (Name) <u>Mathiston, Miss.</u> (Address)	<u>Clay</u>	<u>17</u>	<u>17</u>
(2) Location: <u>10 19 11</u>	<u>Sand</u>	<u>22</u>	<u>39</u>
<u>2</u> miles <u>South</u> of <u>Mathiston</u> (distance) (direction) (Nearest Town)			
(3) Topography: <u>Flat</u> (Hilly) (Flat) (Level)			
(4) Purpose of Well: <u>Municipal</u> (Domestic Irrigation Municipal, Industrial, Other)			

Information upon completion of well:

- (1) Diameter 6 inches.
- (2) Total Depth 39 feet.
- (3) Water Level 10 feet below top of ground.
- (4) Cased to all, Size 6
- (5) Screen: Size 6, Length 20ft
- (6) Were any formations sealed against pollution?
_____ yes, X no.


If YES depth of formation _____

Why _____

Drillers Remarks: gravel wall

CODED

CODED

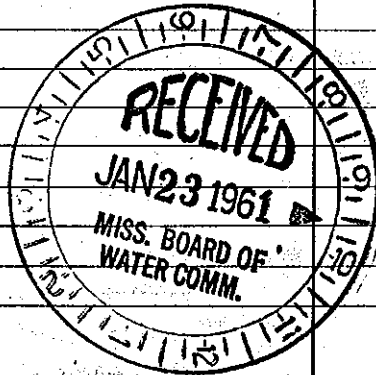

(Use Back Side)

Well No.

Mail this copy to Board of Water Commissioners 429 Miss. St. Jackson, Miss