

CHOCTAW

MISSISSIPPI BOARD OF WATER COMMISSIONERS

B5

WATER WELL DRILLERS LOG

BORED 300

11-7-61

Date: 11/7/61, 19\_\_\_, Driller: L. K. Merrill County Choctaw

(Name)

(1) Owner of Land: Willie Lee Johnson (Name)	Description & Color of Materials Sand, Clay, Red Clay, Shell, etc.	Thick- ness Feet	Depth Feet
228 Methiston Miss. (Address)	Large clay	0	23
(2) Location: 22 19 11 1/4, 1/4, Sec. T. R.	Hard blue clay	23	43
4 miles S.E. Methiston (distance) (direction) (Nearest Town)	Med. Hard grey clay	43	70
(3) Topography: <input checked="" type="checkbox"/> (Hilly) <input type="checkbox"/> (Flat) <input type="checkbox"/> (Level)	Fine blue sand	70	97
(4) Purpose of Well: Domestic (Domestic Irrigation, Municipal, Industrial, Other)	Trace + shale		
	Sand rock @ 97	97	98
	Blue powder sand	98	101
	4" Rock at 101'		
	Blue powder sand	101	110
	4" Rock 110		
	Blue powder sand	110	125


Information upon completion of well:

- (1) Diameter 2 inches.
- (2) Total Depth 125 feet.
- (3) Water Level 50 feet below top of ground.
- (4) Cased to 63', Size 2
- (5) Screen: Size open, Length \_\_\_\_\_
- (6) Were any formations sealed against pollution?  
 yes,  no.

If YES depth of formation Shale Traps at 63'

Why To prevent hole filling

Drillers Remarks: hole below open casing

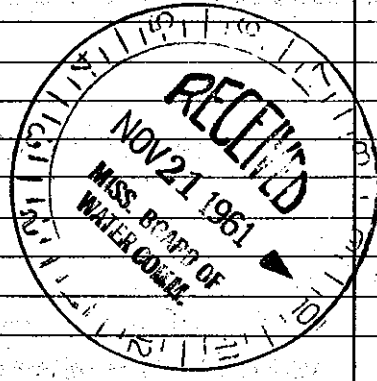

(Use Back Side)

Well No.

Mail this copy to Board of Water Commissioners 429 Miss. St. Jackson, Miss