

CHOCTAW MISSISSIPPI BOARD OF WATER COMMISSIONERS

~~B9~~ B9


WATER WELL DRILLERS LOG

POWER?

Date: 7-20-60 / 7/20/, 1960, Driller: L. K. MERRITT County, CHOCTAW

(Name)

(1) Owner of Land: <u>EDWIN R. TENNESON</u> (Name)	Description & Color of Materials Sand, Clay, Red Clay, Shell, etc.	Thick- ness Feet	Depth Feet
<u>RFD #3 ACKERMAN, MISS</u> (Address)	<u>Surge clay & sand</u>	<u>0</u>	<u>8</u>
(2) Location: <u>13 18 9</u> T R	<u>Soft + orange clay</u>	<u>8</u>	<u>25</u>
<u>8</u> miles <u>South W.</u> of <u>EXORA</u> (distance) (direction) (Nearest Town)	<u>Soft blue clay</u>	<u>25</u>	<u>35</u>
(3) Topography: <input checked="" type="checkbox"/> (Hilly) <input type="checkbox"/> (Flat) <input type="checkbox"/> (Level)	<u>Trace of fine sand</u>	<u>35</u>	<u>55</u>
(4) Purpose of Well: <u>DOMESTIC</u> (Domestic Irrigation, Municipal, Industrial, Other)	<u>Hard blue marl</u>	<u>55</u>	<u>68</u>
Information upon completion of well:	<u>Soft blue fine sand</u>	<u>68</u>	<u>86</u>
(1) Diameter <u>2</u> inches.	<u>Trace of fine sand</u>	<u>86</u>	<u>96</u>
(2) Total Depth <u>105</u> feet.	<u>+ silt bearing rock</u>	<u>96</u>	<u>105</u>
(3) Water Level <u>70</u> feet below top of ground.	<u>Blue marl</u>	<u>96</u>	
(4) Cased to <u>88</u> , Size <u>2</u>			
(5) Screen: Size <u>1/4"</u> , Length <u>6'</u>			
(6) Were any formations sealed against pollution?			
_____ yes, <input checked="" type="checkbox"/> no.			
If YES depth of formation _____			
Why _____			
Drillers Remarks: _____			

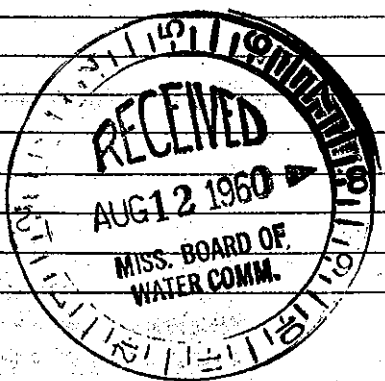

(Use Back Side)

Well No.

Mail this copy to Board of Water Commissioners 429 Miss. St. Jackson, Miss