

CHOCTAW MISSISSIPPI BOARD OF WATER COMMISSIONERS

B 10

7-7-64

WATER WELL DRILLERS LOG CODED

Date: 7-7, 1964, Driller: MERRITT DALLING, Choctaw County, Choctaw

(1) Owner of Land:	Description & Color of Materials Sand, Clay, Red Clay, Shell, etc.	Thick- ness Feet	Depth Feet
Royce Fandren (Name)	Red CLAY	0	12
MATHISTON, MISS (Address)	Red SAND	12	24
321911 (Address)	TAN SAND VERY		
(2) Location: 1/4, 3 1/4, Sec. T R	FINE	24	55
5 miles South of MATHISTON (distance) (direction) (Nearest Town)	Thin Rock		55
(3) Topography: Hilly	TAN SAND VERY	55	79
(Hilly) (Flat) (Level)	FINE	79	85
(4) Purpose of Well: DOMESTIC	CLAY SAND ROCK	85	135
(Domestic Irrigation Municipal, Industrial, Other)	Yellow CLAY SAND	85	135

Information upon completion of well:


- (1) Diameter 2 inches.
- (2) Total Depth 135 feet.
- (3) Water Level 30 feet below top of ground.
- (4) Cased to 84, Size 2"
- (5) Screen: Size Open, Length \_\_\_\_\_.
- (6) Were any formations sealed against pollution?  
 yes, \_\_\_\_\_ no.

If YES depth of formation 4" casing to 72'

Why TO CUT OF SILT.

Drillers Remarks: SHALE TRAP

SET AT 8 H.F.T.

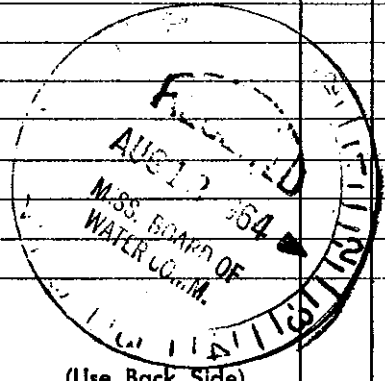

(Use Back Side)

Well No.

Mail this copy to Board of Water Commissioners 429 Miss. St. Jackson, Miss.