

CHOCTAW MISSISSIPPI BOARD OF WATER COMMISSIONERS

B 15

CODED

WATER WELL DRILLERS LOG

9-17-65

Date: 9-17, 1965, Driller: Merritt Drilling Co., County, Choctaw

(Name)

(1) Owner of Land:	Description & Color of Materials Sand, Clay, Red Clay, Shell, etc.	Thick- ness Feet	Depth Feet
Kenneth Nichols (Name)	Blue Gumbo	0	4
RT. MATHURTON, MISS (Address)	BUFF CLAY	4	18
(2) Location: 1/4, 35 19 11 NA, Sec. T R	TAN CLAY + SAND	18	28
5 miles S-E of MATHURTON (distance) (direction) (Nearest Town)	Blue Gumbo	28	35
(3) Topography: Hilly (Hilly) (Flat) (Level)	LIENTE + BLUE CLAY	35	45
(4) Purpose of Well: DOMESTIC (Domestic Irrigation Municipal, Industrial, Other)	SOFT YELLOW CLAY	45	50
	SOFT BLUE CLAY	50	74
	FINE BLUE SAND	74	94
	COARSE WHITE SAND	94	134


Information upon completion of well:

- (1) Diameter 2 inches.
- (2) Total Depth 134 feet.
- (3) Water Level 40 feet below top of ground.
- (4) Cased to 126, Size 2
- (5) Screen: Size 1 1/4, Length 6'
- (6) Were any formations sealed against pollution?
 yes, no.

If YES depth of formation _____

Why _____

Drillers Remarks: _____

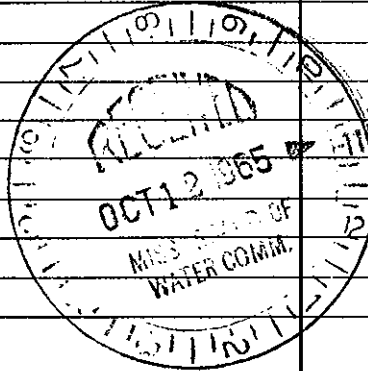

(Use Back Side)

Well No.

Mail this copy to Board of Water Commissioners 429 Miss. St. Jackson, Miss.