

CHOCTAW
B 19
11-21-74


MISSISSIPPI
BOARD OF WATER COMMISSIONERS
416 North State Street
Jackson, Mississippi 39201

CODED

WATER WELL DRILLERS LOG

11-21-74 date well completed
1974 GHM Davall firm name
Choctaw county well located

LANDOWNER: <u>Greg Penrice</u>	description of formations encountered	from	to
<u>Mathiston Miss</u>			
(mailing address)	<u>pipe clay</u>	<u>0</u>	<u>20</u>
WELL LOCATION:	<u>gray clay</u>	<u>20</u>	<u>100</u>
sec. <u>35</u> T. <u>19</u> N. R. <u>11</u> E.	<u>gray sand</u>	<u>100</u>	<u>115</u>
<u>5</u> miles <u>South</u> of <u>Mathiston</u>	<u>gray coarse sand</u>	<u>115</u>	<u>122</u>
(distance) (direction) (nearest town)			
WELL PURPOSE: <u>Home</u> (home, irrigation, municipal, industrial)			
WELL COMPLETION DATA:			
(1) diameter (inches) <u>2"</u>			
(2) total depth (feet) <u>122</u>			
(3) static water level (feet) <u>65</u> below above top of ground.			
(4) casing <u>steel</u> <u>97</u> (material) (depth)			
<u>2"</u> (size) If telescope see back.			
(5) screen <u>5'</u> <u>115 110</u> (length) (depth to top)			
<u>1/4</u> <u>SS 8 plat</u> (size) (material)			
(6) pump <u>1</u> <u>10</u> (HP) (yield gpm)			
<u>electric</u> (type power)			
(7) electric log <u>no</u> (yes or no)			
(organization running log)			
(8) how well bottom plugged			
DRILLERS REMARKS:			

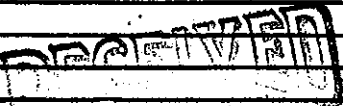

DEC - 9 1974

MISS. BD. OF WATER COMM