

C 1.

WATER WELL DRILLERS LOG

CODED

7-28-60

Date: 7/28/1960, Driller: E. K. MERRITT County CHOCTAW


(Name)

(1) Owner of Land: MELVIN BOY
 (Name)
 R 75 NORTHMOLEN, MISS.
 (Address)
 (2) Location: 1/4, 4 18 9, 1/4, Sec. T R.
 6 miles SE of TOMMIE
 (distance) (direction) (Nearest Town)
 (3) Topography: (Hilly) (Flat) (Level)
 (4) Purpose of Well: DOMESTIC
 (Domestic Irrigation, Municipal, Industrial, Other)

Description & Color of Materials Sand, Clay, Red Clay, Shell, etc.	Thick- ness Feet	Depth Feet
Red Clay	0	3
White + Buff Clay	3	12
Blue Clay	12	15
Bay Clay + sand rock	15	30
Block Chalk + Trone		
of shale, fine blue sand	30	39
Tronstone	39	43
Block Clay Trone		
of fine blue sand + shale	43	60
Hard blue Clay	60	68
Med. soft blue clay		
Trone of sand + shale	68	78
Hard Clay + shale	78	85
Shale, Clay + blue sand	85	105
Fine blue sand + shale	105	125
Fine blue sand + shale cut with soft clay	125	147

Information upon completion of well:

(1) Diameter 2 inches.
 (2) Total Depth 147 feet.
 (3) Water Level 45 feet below top of ground.
 (4) Cased to 84, Size 2
 (5) Screen: Size open, Length _____
 (6) Were any formations sealed against pollution?
 yes, no. 84
 If YES depth of formation 2 shale Trone.
 Why TO prevent hole.
 Drillers Remarks: from filling
 With sand + belt below
 bottom of casing.

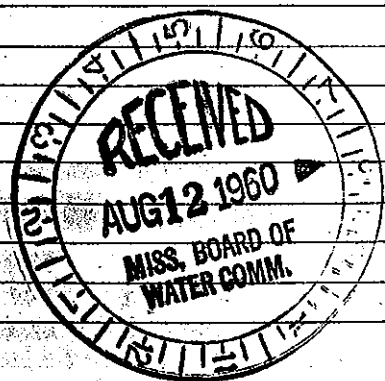

Well No.

(Use Back Side)