

CHOCTAW

MISSISSIPPI BOARD OF WATER COMMISSIONERS

C 2

6-21-62

WATER WELL DRILLERS LOG

Date: 6-21, 1962, Driller: Smith & Presley County Choctaw

(Name)

(1) Owner of Land:	Description & Color of Materials Sand, Clay, Red Clay, Shell, etc.	Thick- ness Feet	Depth Feet
<u>James I. Henderson</u> (Name)	<u>red clay</u>	<u>6</u>	<u>6</u>
<u>Stewart Miss</u> (Address)	<u>yellow sand</u>	<u>10</u>	<u>16</u>
(2) Location: <u>SW 1/4, NE 1/4, Sec. 22 18 8</u>	<u>white clay</u>	<u>8</u>	<u>24</u>
<u>3</u> miles <u>south</u> , of <u>Stewart</u> (distance) (direction) (Nearest Town)	<u>fine white sand</u>	<u>24</u>	<u>48</u>
(3) Topography: <u>Hilly</u> (Hilly) (Flat) (Level)	<u>had pan two or three inches</u>		
(4) Purpose of Well: <u>Domestic</u> (Domestic Irrigation, Municipal, Industrial, Other)	<u>a medium sand</u>		
	<u>white</u>	<u>55</u>	<u>103</u>
	<u>Coarse gray sand</u>	<u>17</u>	<u>120</u>
	<u>a gray clay and sand mixture</u>	<u>4</u>	<u>124</u>


Information upon completion of well:

- (1) Diameter 2 inches.
- (2) Total Depth 124 feet.
- (3) Water Level 43 to 45 feet below top of ground.
- (4) Cased to 105, Size 2"
- (5) Screen: Size 1/4, Length 6'
- (6) Were any formations sealed against pollution?
no

If YES depth of formation _____

Why _____

Drillers Remarks: _____

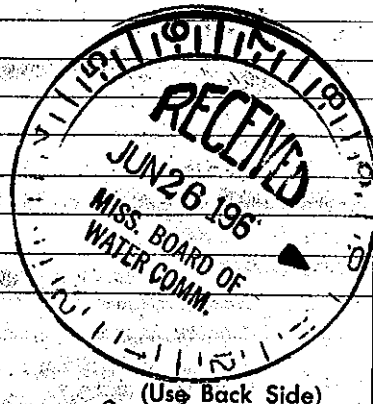

(Use Back Side)

24 Well No.

Mail this copy to Board of Water Commissioners 429 Miss. St. Jackson, Miss