

CHOCTAW

MISSISSIPPI BOARD OF WATER COMMISSIONERS

C4

WATER WELL DRILLERS LOG

Date: 6-12-64, 1964, Driller: Smith & Presley, CODED County: Choctaw

(1) Owner of Land:	Description & Color of Materials Sand, Clay, Red Clay, Shell, etc.	Thick- ness Feet	Depth Feet
AB Clark (Name)	yellow clay	17	17
Stewart Miss R. 2. (Address)	yellow clay	10	27
(2) Location: S 1/2 SW 1/4 NW 1/4 Sec. 34 T8 R8	Red sand	20	47
4 miles south of Stewart (distance) (direction) (Nearest Town)	white sand with little white clay mixture	20	67
(3) Topography: Hilly (Hilly) (Flat) (Level)	white coarse sand	50	117
(4) Purpose of Well: Domestic (Domestic Irrigation Municipal, Industrial, Other)	light gray sand	9	126

Information upon completion of well:

(1) Diameter: 2 inches.

(2) Total Depth: 126 feet.

(3) Water Level: 20 feet below top of ground.

(4) Cased to: 120, Size 2


(5) Screen: Size 1/4, Length 6"

(6) Were any formations sealed against pollution?  
 \_\_\_\_\_ yes, \_\_\_\_\_ no.

If YES depth of formation \_\_\_\_\_

Why \_\_\_\_\_

Drillers Remarks: \_\_\_\_\_

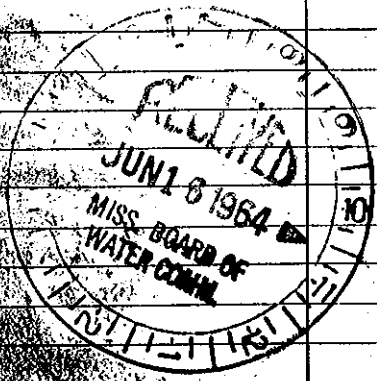

53  
N

Mail this copy to Board of Water Commissioners, 429 Miss. St. Jackson, Miss.