

CHOCTAW

WATER WELL DRILLERS LOG

CODED


Date: 10-1-63, 1963 Driller: MERRITT DRILLING CO. County CHOCTAW
(Name)

(1) Owner of Land: George DEAN
(Name)
WEIR MISS.
(Address)
(2) Location: 22 18 9
9 miles NORTH of WEIR
(distance) (direction) (Nearest Town)
(3) Topography: HILLY
(Hilly) (Flat) (Level)
(4) Purpose of Well:
(Domestic Irrigation
Municipal, Industrial, Other)

Description & Color of Materials Sand, Clay, Red Clay, Shell, etc.	Thick- ness Feet	Depth Feet
<u>Red CLAY</u>	<u>0</u>	<u>6</u>
<u>TAN SAND.</u>	<u>6</u>	<u>50</u>
<u>Yellow SAND</u>	<u>50</u>	<u>80</u>

Information upon completion of well:

(1) Diameter 2 inches.
 (2) Total Depth 80 feet.
 (3) Water Level 40 feet below top of ground.
 (4) Cased to 74, Size 2
 (5) Screen: Size 1 1/4, Length 6'
 (6) Were any formations sealed against pollution?
 _____ yes, no.
 If YES depth of formation _____
 Why _____
 Drillers Remarks: _____

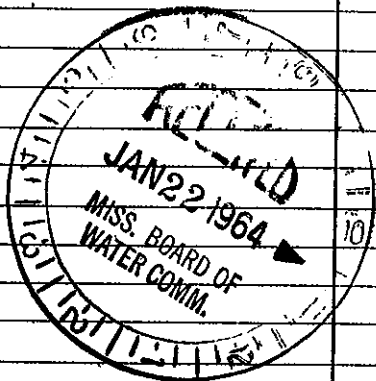

(Use Back Side)

Well No.