

CHOCTAW MISSISSIPPI BOARD OF WATER COMMISSIONERS

C 7

4-26-66

WATER WELL DRILLERS LOG

CODED

Date: 4-26, 19 66, Driller: Meritt Drilling Co. County Choctaw

~~James Ramage~~ (Name)

(1) Owner of Land: JAMES RAMAGE
(Name)
CLARKS Dale Miss
(Address)

(2) Location: 36 18 8
1/4, 1/4, Sec. T R
5 miles S.E. of STEWART
(distance) (direction) (Nearest Town)

(3) Topography: Hilly
(Hilly) (Flat) (Level)

(4) Purpose of Well: DOMESTIC
(Domestic Irrigation Municipal, Industrial, Other)

Description & Color of Materials Sand, Clay, Red Clay, Shell, etc.	Thick- ness Feet	Depth Feet
Red Clay	0	10
BUFF CLAY	10	32
Red Clay	32	34
LIGNITE	34	35
Blue clay	35	36
BROWN SAND	36	37
LIGNITE	39	40
Blue clay + lignite	40	60
Blue clay + SAND	60	85
WHITE SAND	85	126

Information upon completion of well:

(1) Diameter 2 inches.

(2) Total Depth 126 feet.

(3) Water Level 85 feet below top of ground.

(4) Cased to 119, Size 2


(5) Screen: Size 1 1/4, Length 6'

(6) Were any formations sealed against pollution?
 yes, no.

If YES depth of formation _____

Why _____

Drillers Remarks: _____

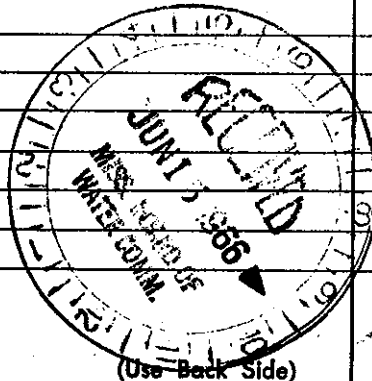

Well No. _____

Mail this copy to Board of Water Commissioners 429 Miss. St. Jackson, Miss.