

Choctaw  
C 8  
1-67

MISSISSIPPI BOARD OF WATER COMMISSIONERS

WATER WELL DRILLERS LOG

CODED

Date: 1-5-1967, Driller: Smith Forge & Welding Co., Choctaw  
(When well drilled) (Name) (Where well is located)

| (1) Owner of Land: <u>Mann Burton</u><br>(Name)<br><u>Stewart R 2</u><br>(Address) | Description & Color of Materials<br>Sand, Clay, Red Clay, Shell, etc. | Thick-<br>ness<br>Feet | Depth<br>Feet |
|--|---|------------------------|---------------|
|  | Red clay  | 14                     | 14            |
|  | open cavity   | 1                      | 15            |
|  | gray clay   | 15                     | 30            |
|  | white clay thin   |                        |               |
|  | calc. fritting  | 20                     | 50            |
|  | Rock  | 5"                     |               |
|  | blue clay   | 13                     | 63            |
|  | gray silt & sand  | 50                     | 113           |
|  | sharp pan   | 3"                     |               |
|  | gray sand   |                        |               |
|  | medium  | 30                     | 143           |
|  | 9 better grade  | 31                     | 174           |

Information upon completion of well:

(1) Diameter 2 inches.

(2) Total Depth 174 feet.

(3) Water Level 75 feet below top of ground.

(4) Cased to 157, Size 2

(5) Screen: Size 1 1/4, Length 6'

(6) Were any formations sealed against pollution?  
 \_\_\_\_\_ yes,  no.

If YES depth of formation \_\_\_\_\_


Why \_\_\_\_\_

Drillers Remarks: \_\_\_\_\_

Yield in gpm: \_\_\_\_\_

Size pump: \_\_\_\_\_

Type power: \_\_\_\_\_

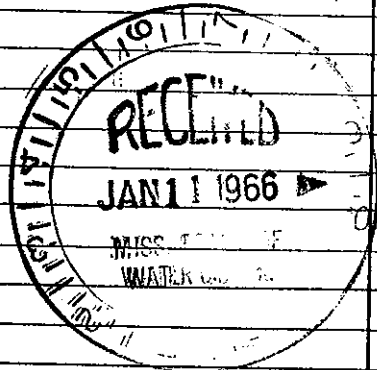

34

Mail this copy to Board of Water Commissioners 429 Miss. St. Jackson, Miss.