

CHOCTAW MISS.

~~D4~~ D4

7-25-60

WATER WELL DRILLERS LOG

Date: 7/25/60, Driller: E.K. MERRITT County CHOCTAW

(Name)

(1) Owner of Land: IRBY L. VANCE
(Name)
2783 HACKERMAN, MISS
(Address)
18 18 10
(2) Location: 1/4, 1/4, Sec. 18 T. 18 R. 10
8 miles S. W, of EXPORIA
(distance) (direction) (Nearest Town)
(3) Topography: (Hilly) (Flat) (Level)
(4) Purpose of Well: DOMESTIC
(Domestic Irrigation
Municipal, Industrial, Other)


| Description & Color of Materials Sand, Clay, Red Clay, Shell, etc. | Thick- ness Feet | Depth Feet |
|---|------------------------|---------------|
| Surface Clay + sand | 0 | 10 |
| Limestone | 10 | 23 |
| Lignite | 23 | 27 |
| Limestone | 27 | 28 |
| Hard lignite | 28 | 31 |
| Hard blue clay | 31 | 43 |
| Soft clay + silt | 43 | 45 |
| Hard blue clay | 45 | 53 |
| Soft clay + silt | 53 | 55 |
| Hard grey clay | 55 | 64 |
| Hard lignite | 64 | 76 |
| light grey clay RODED | 76 | 103 |
| med. hard | | |
| Hard lignite | 103 | 106 |
| Hard grey clay | 106 | 123 |
| Hard lignite | 123 | 127 |
| light grey clay | 127 | 139 |
| med. soft | | |
| Hard lignite | 139 | 132 |
| Soft light grey clay | 132 | 137 |
| Fine grey sand | 137 | 163 |
| + mica, traces of clay | | |
| Hard grey clay | 163 | 165 |
| Hard lignite | 165 | 169 |
| Hard brown clay | 169 | 175 |
| Soft grey + brown | | |
| Soft grey + silt | 175 | 180 |

Information upon completion of well:

(1) Diameter 2 inches.
(2) Total Depth 180 feet.
(3) Water Level 60 feet below top of ground.
(4) Cased to 84, Size 2
(5) Screen: Size open, Length _____
(6) Were any formations sealed against pollution?
 yes, no.

If YES depth of formation 84

Why To prevent hole from filling with sand + silt below bottom of casing

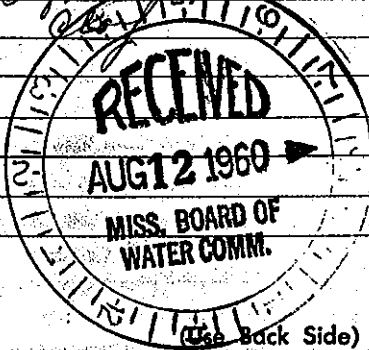

Well No.

Mail this copy to Board of Water Commissioners 429 Miss. St. Jackson, Miss