

CHOCTAW MISSISSIPPI BOARD OF WATER COMMISSIONERS

CODED

WATER WELL DRILLERS LOG

Date: 9-15-60, 1960, Driller: L. K. Merritt County Choctaw  
 (Name)


(1) Owner of Land: A. H. Henderson  
 (Name)  
Ackerman, Miss.  
 (Address)  
 (2) Location: 7 18 10  
 1/4, 1/4, Sec. T R  
8 miles S/W of Loupara  
 (distance) (direction) (Nearest Town)  
 (3) Topography:  (Hilly)  (Flat)  (Level)  
 (4) Purpose of Well: Domestic  
 (Domestic Irrigation, Municipal, Industrial, Other)

Description & Color of Materials Sand, Clay, Red Clay, Shell, etc.	Thick- ness Feet	Depth Feet
Red Clay	0	0
Light grey clay	6	17
Hard Blue Clay	17	27
Soft Lignite	22	24
Hard Blue Clay	24	40
Hard Lignite	40	44
Hard Green Clay	44	57
2" Rock at 57'		
Light Grey Clay	57	59
Hard Lignite	59	61
Red Hard Light Grey Clay	61	70
Dark Grey Clay & Shale	70	84
Dark Grey Clay, Shale	84	125
Thick blue sand		
Fine blue sand	125	150
Shale - trace of clay	150	157
Fine blue sand		
Mica + silt	157	167
Dark Clay & Shale		

Information upon completion of well:

(1) Diameter 2 inches.  
 (2) Total Depth 167 feet.  
 (3) Water Level 63 feet below top of ground.  
 (4) Cased to 78, Size 2  
 (5) Screen: Size open, Length \_\_\_\_\_  
 (6) Were any formations sealed against pollution?  
 yes,  no.  
 If YES depth of formation 78

2 Shale Traps at 78'

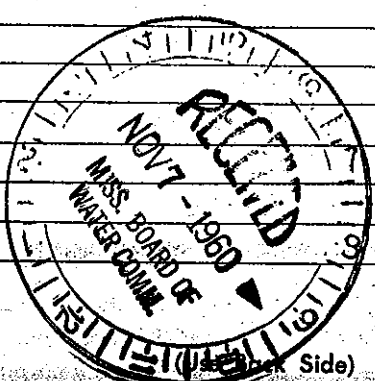

Well No. \_\_\_\_\_

Mail this copy to Board of Water Commissioners 429 Miss. St. Jackson, Miss.