

**CHOCTAW MISSISSIPPI BOARD OF WATER COMMISSIONERS**

CODEL.

D<sup>6</sup>

**WATER WELL DRILLERS LOG**

6-28-65


Date: 6-28, 1965, Driller: MERRITT DRILLING CO. Choctaw  
(Name)

(1) Owner of Land: James Ready  
(Name)  
RT # 2 - Ackerman, Miss.  
(Address)  
17 18 10  
(2) Location: 1/4, 1/4 Sec. T R  
9 miles N. W., of Ackerman  
(distance) (direction) (Nearest Town)  
(3) Topography: FIAT  
(Hilly) (Flat) (Level)  
(4) Purpose of Well: DOMESTIC  
(Domestic Irrigation, Municipal, Industrial, Other)

Description & Color of Materials Sand, Clay, Red Clay, Shell, etc.	Thick- ness Feet	Depth Feet
White Clay	0	12
TAN CLAY	12	18
LIGNITE	18	30
Grey clay + sand	30	38
Blue clay	34	43
LIGNITE	43	50
GREEN CLAY	50	52
FINE BLUE SAND	52	60
Blue clay	60	61
3" ROCK		
Blue clay	61	69
LIGNITE	69	75
FINE BLUE SAND + MICA	75	100
LIGNITE	100	101
Blue SAND	101	115
Blue clay	115	126

Information upon completion of well:

(1) Diameter 2 inches.  
(2) Total Depth 126 feet.  
(3) Water Level 5 feet below top of ground.  
(4) Cased to 4 1/2', Size 4"  
(5) Screen: Size open end, Length \_\_\_\_\_  
(6) Were any formations sealed against pollution?  
✓ yes, \_\_\_\_\_ no.  
If YES depth of formation 4" service casing - to 4 ft.  
Why \_\_\_\_\_  
Drillers Remarks: \_\_\_\_\_

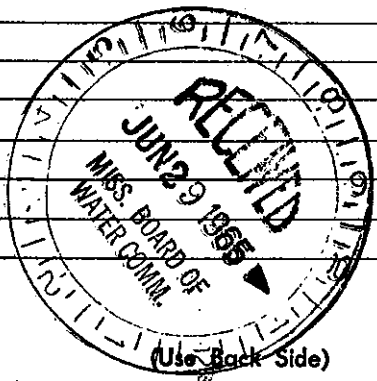

Well No.

Mail this copy to Board of Water Commissioners 429 Miss. St. Jackson, Mis: