

CHOCTAW

MISSISSIPPI BOARD OF WATER COMMISSIONERS

D9

7-6-63

WATER WELL DRILLERS LOG

CODED

Date: 7-6, 1963, Driller: Mearitt Sawing County, ~~Washington~~

(Name)


(1) Owner of Land:	Description & Color of Materials Sand, Clay, Red Clay, Shell, etc.	Thick- ness Feet	Depth Feet
ALVIN WILKES (Name)	Red CLAY	0	28
Eupora Miss. (Address)	LIGNITE	28	30
(2) Location: 1/4, 7 18 10, Sec. T. R.	GREEN CLAY	30	37
5 miles South of Eupora (distance) (direction) (Nearest Town)	FINE BLUE SAND	42	58
(3) Topography: Hilly	LIGNITE	58	59
(Hilly) (Flat) (Level)	GRAY CLAY	59	64
(4) Purpose of Well: DOMESTIC	LIGNITE & CLAY	64	90
(Domestic Irrigation Municipal, Industrial, Other)	SOFT Blue CLAY	70	85
	GRAY SANDY MIM	85	85
	SAND & MIM (mica)	85	126

Information upon completion of well:

- (1) Diameter 2 inches.
- (2) Total Depth 126 feet.
- (3) Water Level 44 feet below top of ground.
- (4) Cased to 75, Size 2
- (5) Screen: Size 2 open Length \_\_\_\_\_
- (6) Were any formations sealed against pollution?  
✓ yes, \_\_\_\_\_ no.

If YES depth of formation Shale trap  
Why 75 ft

Drillers Remarks: \_\_\_\_\_

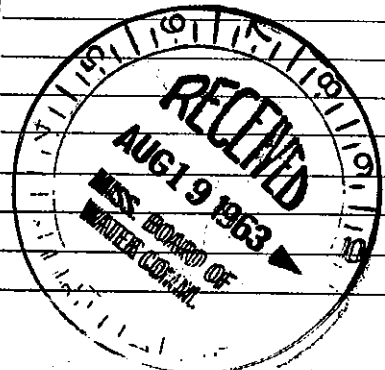

(Use Back Side)

Well No.

Retain this copy for your office files.