

CHOCTAW MISSISSIPPI BOARD OF WATER COMMISSIONERS

~~6-18-64~~ D 13

WATER WELL DRILLERS LOG

Date: 6-18, 1964, Driller: MERRITT DRILLING CO. <sup>CODED</sup> Choctaw town County Choctaw


(Name)

(1) Owner of Land: JAMES BOWIE  
(Name)  
RT. 3. ACKERMAN, MISS  
(Address)  
(2) Location: 1/4, 23 18 10 Sec. T R. R.  
7 miles NORTH of ACKERMAN  
(distance) (direction) (Nearest Town)  
(3) Topography: Hilly  
(Hilly) (Flat) (Level)  
(4) Purpose of Well: DOMESTIC  
(Domestic Irrigation  
Municipal, Industrial, Other)

Description & Color of Materials Sand, Clay, Red Clay, Shell, etc.	Thick- ness Feet	Depth Feet
Red CLAY	0	12
ROCK		12
<del>Red</del> CLAY	13	18
Blue MARL	18	21
LIGNITE	21	22
Blue Gumbo	22	51
ROCK		51
Blue Gumbo + LIGNITE	51	58
GREEN CLAY	58	61
GRAY CLAY	61	71
LIGNITE	71	73
GRAY CLAY	73	83
GREEN CLAY	83	85
ROCK	85	85 1/2
Blue CLAY + HARD LIGNITE	86	95
GREEN CLAY	95	105
ROCK	105	106
Blue HARD CLAY	106	120
ROCK		120
Blue CLAY + LIGNITE	121	140
TRACI OF Blue SAND		
Blue SAND	140	152
Blue CLAY + LIGNITE	152	168
GRAY CLAY, SOFT.	168	198
Blue SAND.	198	214

Information upon completion of well:

(1) Diameter 2 inches.  
(2) Total Depth 214 feet.  
(3) Water Level 80 feet below top of ground.  
(4) Cased to 126, Size 2  
(5) Screen: Size OPEN, Length \_\_\_\_\_  
(6) Were any formations sealed against pollution?  
\_\_\_\_\_ yes, \_\_\_\_\_ no.  
If YES depth of formation Shale trap  
AT 126 FT.  
Why \_\_\_\_\_  
Drillers Remarks: \_\_\_\_\_

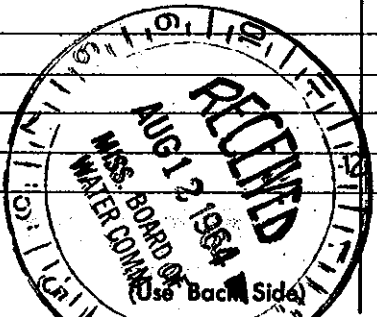

Well No.

Mail this copy to Board of Water Commissioners 429 Miss. St. Jackson, Miss.