

MISSISSIPPI BOARD OF WATER COMMISSIONERS

CHOCTAW

9-7-63

WATER WELL DRILLERS LOG

CODED


Date: 9-7-63, 1963, Driller: Merritt Drilling Co. County Choctaw
(Name)

(1) Owner of Land: H. A. Brewitt
(Name)
Rtd. Ackerman, Miss
(Address)
33 18 10
(2) Location: $\frac{1}{4}$, $\frac{1}{4}$, Sec. T. R.
7 miles N.W., of Ackerman
(distance) (direction) (Nearest Town)
(3) Topography: Hilly
(Hilly) (Flat) (Level)
(4) Purpose of Well: Domestic
(Domestic Irrigation
Municipal, Industrial, Other)

Description & Color of Materials Sand, Clay, Red Clay, Shell, etc.	Thick- ness Feet	Depth Feet
<u>0-2' SAND ROCK</u>	<u>0</u>	<u>2</u>
<u>Red SAND</u>	<u>2</u>	<u>22</u>
<u>Blue CLAY</u>	<u>22</u>	<u>60</u>
<u>SOFT CLAY</u>	<u>60</u>	<u>65</u>
<u>LIGNITE</u>	<u>65</u>	<u>66</u>
<u>GREEN CLAY</u>	<u>66</u>	<u>68</u>
<u>LIGNITE</u>	<u>68</u>	<u>74</u>
<u>GREEN CLAY</u>	<u>74</u>	<u>90</u>
<u>LIGNITE & Blue CLAY</u>	<u>90</u>	<u>100</u>
<u>SOFT Blue CLAY</u>	<u>100</u>	<u>110</u>
<u>LIGNITE</u>	<u>110</u>	<u>112</u>
<u>Blue CLAY & CHALK</u>	<u>112</u>	<u>132</u>
<u>FINE Blue SAND</u>	<u>132</u>	<u>138</u>
<u>Blue CLAY & SAND</u>	<u>138</u>	<u>140</u>
<u>ROCK</u>	<u>140</u>	
<u>Blue CLAY & LIGNITE</u>	<u>141</u>	<u>147</u>
<u>LIGNITE</u>	<u>147</u>	<u>150</u>
<u>Blue CLAY & INCREASE SAND</u>	<u>150</u>	<u>157</u>
<u>2" ROCK</u>	<u>157</u>	
<u>Blue sand very FINE</u>	<u>159</u>	<u>164</u>
<u>15" ROCK</u>	<u>164</u>	<u>165</u>
<u>15" FINE Blue SAND</u>	<u>165</u>	<u>184</u>

Information upon completion of well:

(1) Diameter 2 inches.
(2) Total Depth 185 feet.
(3) Water Level _____ feet below top of ground.
(4) Cased to 126, Size 2"
(5) Screen: Size Open; Length _____
(6) Were any formations sealed against pollution?
✓ yes, _____ no.
If YES depth of formation Shell trap
5 ft at 126
Why _____
Drillers Remarks: _____

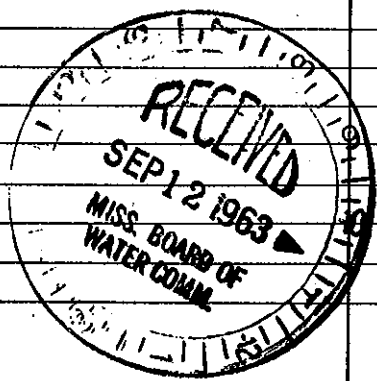

(Use Back Side)

Well No.

Mail this copy to Board of Water Commissioners 429 Miss. St. Jackson, Miss.