

CHOCTAW

MISSISSIPPI BOARD OF WATER COMMISSIONERS


~~10-29-63~~ D16

WATER WELL DRILLERS LOG

CODED

Date: 10-29-63, 1963, Driller: J L Merritt, County: Choctaw
(Name)

(1) Owner of Land:	Description & Color of Materials Sand, Clay, Red Clay, Shell, etc.	Thick- ness Feet	Depth Feet
Haywood Perry (Name) Ackerman, Miss. (Address)	Red Clay	0	10
(2) Location: 1/4, 36, 18 10 2 miles North of Ackerman (distance) (direction) (Nearest Town)	Blue clay	10	35
	Blue sand	35	45
	Lignite	45	55
	Blue clay	55	100
	Fine Blue sand	100	126
(3) Topography: <input checked="" type="checkbox"/> (Hilly) <input type="checkbox"/> (Flat) <input type="checkbox"/> (Level)			
(4) Purpose of Well: Domestic (Domestic Irrigation Municipal, Industrial, Other)			
Information upon completion of well:			
(1) Diameter 2" inches.			
(2) Total Depth 126 feet.			
(3) Water Level 48 feet below top of ground.			
(4) Cased to 80, Size 2"			
(5) Screen: Size 2", Length 67'			
(6) Were any formations sealed against pollution? yes, <input checked="" type="checkbox"/> no.			
If YES depth of formation			
Why			
Drillers Remarks:			

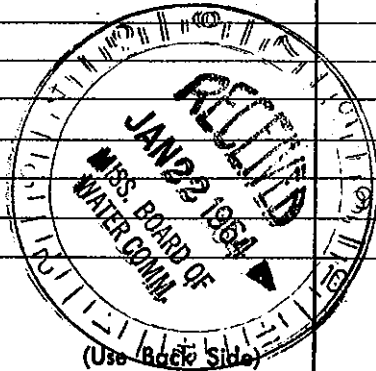

Well No.

Mail this copy to Board of Water Commissioners 429 Miss. St. Jackson, Miss