

CHOCTAW MISSISSIPPI BOARD OF WATER COMMISSIONERS

~~10~~ D17 WATER WELL DRILLERS LOG

CODED CHOCTAW

Date: 5-17-64, 1964, Driller: MERRITT DRILLING CO County WINSTON
(Name)

(1) Owner of Land: <u>H.M. BIGGERS</u> (Name) <u>Lubbock TEXAS</u> (Address) <u>201810</u>	Description & Color of Materials Sand, Clay, Red Clay, Shell, etc.	Thick- ness Feet	Depth Feet
(2) Location: <u>1/4</u> , <u>1/4</u> , Sec. <u>T</u> <u>R</u> <u>12</u> miles <u>N.W.</u> , of <u>Ackerly</u> (distance) (direction) (Nearest Town)	<u>Red CLAY</u>	<u>0</u>	<u>12</u>
(3) Topography: <u>Hilly</u> (Hilly) (Flat) (Level)	<u>Red SANDY CLAY</u>	<u>12</u>	<u>20</u>
(4) Purpose of Well: <u>DOMESTIC</u> (Domestic Irrigation Municipal, Industrial, Other)	<u>TAN SAND</u>	<u>28</u>	<u>110</u>
	<u>White SAND VERY HARD</u>	<u>110</u>	<u>139</u>
	<u>ROCK</u>	<u>139</u>	<u>140</u>
	<u>Blue CLAY, SOFT</u>	<u>140</u>	<u>165</u>
	<u>Mixed CLAY + LIGNITE</u>	<u>165</u>	<u>170</u>
	<u>Blue CLAY</u>	<u>170</u>	<u>256</u>
	<u>GREEN CLAY</u>	<u>256</u>	<u>266</u>
	<u>Blue CLAY WITH</u>		
	<u>TRACE OF Blue SAND</u>	<u>266</u>	<u>315</u>
	<u>FINE Blue SAND</u>	<u>315</u>	<u>337</u>

Information upon completion of well:

(1) Diameter 2 inches.

(2) Total Depth 339 feet.

(3) Water Level 189 feet below top of ground.

(4) Cased to 218, Size 2


(5) Screen: Size OPEN, Length _____

(6) Were any formations sealed against pollution?
✓ yes, _____ no.

If YES depth of formation Shale TRAP
SET AT 210 FT.

Why _____

Drillers Remarks: NO WATER
Bearing formation from
0 to 315 FT.

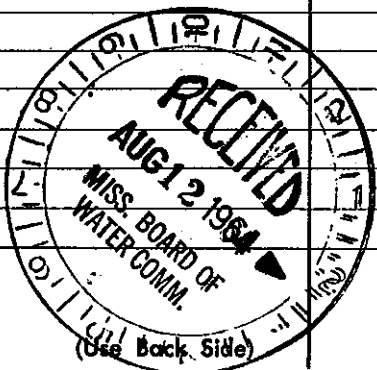

Well No.

Mail this copy to Board of Water Commissioners 429 Miss. St. Jackson, Miss.