State W	ell Report  For Office Use Only:		
Part 1 – D	oriller's Log		
County: Mississinni Denortmen	a f Engineermental Onality   Amifer		
	nd Water Resources Well #: D-89		
P.O. E	30X 10031		
1001100111	[S 39289-0631   L. S. Elevation:   961-5210		
	4-6938 (fax) E-log#:		
State Law requires that this report be prepared by the lice	ense holder responsible for the work and filed with the		
Department at the above address within 30 days of comp	dation of Aprilling of the well of Doleroic.		
Information on Well Owner	Latitude: 33° 32', 42" Longitude: 82° 40', 18"		
(Landowner if borehole is not for a water well)	Latitude: 33° 37' 42" Longitude: 82° 40' 16"		
Owner Name MS Liquid Wing Co.	Method of Lat/Long (circle one): Conventional Survey,		
Mailing Address: 1000 MC Intile Rd.	1		
·	USGS quad, Hand-held GPS, Survey-grade GPS		
Actemor, US 39735	SE 1/4 Mu 1/4 Sec 33 Twn 18 M Rng 106		
	90 14 MO 14 Sec 55 1 WIII 10 14 MIN 10 MIN 1		
City State Zip Code	Distance Direction Nearest Town		
	Z15 Miles NW of Chaster		
Telephone No. (WW) 367 -5200			
Well / Bor	ehole Data		
Date drilling started: 9-7004 Date drilling completed: 11-5-	(2) Hole depth: 175/ Hole diameter: /9"		
Location of the source of any surface water used for drilling: Method of dosing and volume of Chlorine used in drilling and deve	le Byuny Creek		
Method of dosing and volume of Chlorine used in drilling and deve	elopment: 1 Gal blean to 300 Gal works		
Logs run (circle all applicable): No log run Electric Gamma Ray Density Sonic Neutron Other:			
Name of organization running log(s): Clarty Clarky seed corp.			
Purpose of borehole (check one): Water Well Geotechnical/Geological Investigation Ground Source Heat Pump			
Seismic Survey Other (describe)  If drilling is not related to water well construction, skip the remainder of this block			
Purpose of Well (check one): Home Industrial Public Supp	ly Irrigation Fish Culture Other:		
If a flowing well, method of flow regulation: Valve	Other (describe)		
Static Water Level:feet above or below (circle one)	land surface Date measured: 11-17-06 RECEIVE		
Method of Measurement (circle one) steel tape	DEC 11 2000		
Well depth: 175 Well grouted to a depth of 130 feet Ty	ne of grout (circle one): Neat Cemen Bentonite Mix		
Casing length: 140 feet Casing diameter: 4	inches Type of casing:BY: OLWA		
Screen length: 30 feet Screen diameter. 9	inches Type of screen:		
Screen slot size: O · O O inches Setting depth: From 140 feet to 170 feet			
Type of completion (circle all applicable): Gravel packed Und	erreamed Telescoped Open hole Natural Development		

Top of lap pipe or reduction in casing: \_\_\_\_\_ feet. If telescoped or more than one screen, describe on next page

Form: OLWR-SWR-1A


#### The sketch below only required for water wells

## If well telescopes, show depths on sketch. Ground Level

# Description of formations encountered must be provided for all wells and boreholes, unless specifically exempted by regulations

Description of Formations Encountered		o (depth)
SAND	Ground Level	17
C/44	17	21
Cicnite	21	77
CiAV	22	40
Vicaite	40	47
CIGAY	47	53
13. 10	53	57
CPAN	57	84
Vicute	84	28
ugute	88	131
Lighte	131	137
1 GAL	137	140
6.4.40	140	153
1 / Carlo	153	157
CENNE	157	159
C1010	159	170
CLAY	170	135
Chay		

If more than one screen, show location of each on sketch

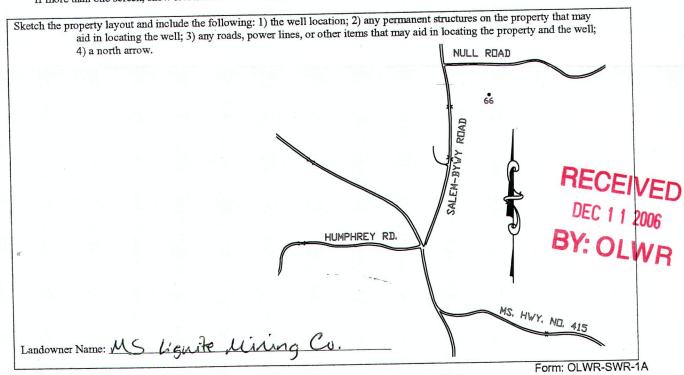

I certify that the well/borehole was drilled, constructed, and completed in accordance with all applicable requirements of the Mississippi Department of Environmental Quality and the Mississippi Department of Health regulations, if applicable, and state

Randy SAIETS MSLIC 0779 CM 12-1-06

Print Name of Responsible Licensee and License No.

Date

Signature of Licensee

#### STATE WELL REPORT

### 

Test Pumping Rate: \_\_\_\_\_

#### Part 2

Pump Installer's Completion Report

Mississippi Department of Environmental Quality
Office of Land and Water Resources
P.O. Box 10631

Jackson, MS 39289-0631 (601)961-5210 (601)354-6938 (fax) For Office Use Only:

Aquifer:

Well #: D - S - Elevation:

(601)354-6938 (fax) Copy information from block on Part 1 This part of the report must be completed by a licensed water well contractor or a licensed pump installer. A copy of Part 1 of the report must be attached and both parts filed with the Department at the above address within 30 days of well completion. Well Location Well Owner Information Latitude: 33° 32′ 42″ Longitude: 67° 40' 18" ignite Mining Co Owner Name; 15 Method of Lat/Long (check one): Conventional Survey\_\_\_\_, Mailing Address: 1000 Alc Jackie Pd. USGS quad\_\_\_\_\_, Hand-held GPS\_\_\_\_, Survey-grade GPS\_\_\_\_ Actembre, MS 35735
State Zip Code SE 1/4 NW 1/4 Sec 33 T 18N R 10E Nearest Town Direction Distance 7.5 Miles NW of Chester Telephone No. (62) 387-5200 Power Type Pump Type Circle one Circle one Gasoline Engine Natural Gas Diesel Engine Submersible Jet Air Lift Tractor PTO Mectric Motor Hand Turbine Piston Bucket Other (specify): \_\_\_\_\_ Windmill Flowing Well Centrifugal Rotary 112 Horse Power Rating of Motor: Other (specify): \_\_ Date Pump Installed: 11-17-06 138 \_\_\_\_ feet Setting Depth: Number of Stages: Rated Pump Capacity: 7,5 Gallons Per Minute Method of Measuring Water Leve Pump Test Data Circle one Date Well Tested: 11-22-06 Electric Measuring Line Air Line Static Water Level (A): 91 Feet Below Land Surface Other (specify): \_\_\_\_ Pumping Water Level (B): \_\_\_\_\_\_\_Feet Below Land Surface Drawdown [(B) - (A)]: 44 Feet Below Land Surface For flowing well, measured shut in head: \_\_\_\_\_feet

<u> </u>		
I HEREBY CERTIFY that the above statements are true to the best of a  RANDY SAIETS MS Lie 0729 GM	ny knowledge.	<u> </u>
Print Name of Pump Installer and License No. (if applicable)	Signature of Pump Installer	

3 \_Gallons Per Minute

Duration of Pump Test (minimum 4 hours): \_\_\_\_\_\_hours

Form: OLWR-SWR-1B

Well yielded 3 GPM with a drawdown of

44 feet after 8 hours of pumping