

County: Choctaw
 Permit #: MSLIC 0779 G-M
 Driller: Randy Sellers
 Date drilling completed: 11-17-06

State Well Report

Part 1 - Driller's Log

Mississippi Department of Environmental Quality
 Office of Land and Water Resources
 P.O. Box 10631
 Jackson, MS 39289-0631
 (601)961-5210
 (601)354-6938 (fax)

For Office Use Only:
 Aquifer: _____
 Well #: D-93
 L. S. Elevation: _____
 E-log #: _____

State Law requires that this report be prepared by the license holder responsible for the work and filed with the Department at the above address within 30 days of completion of drilling of the well or borehole.

<p>Information on Well Owner <i>(Landowner if borehole is not for a water well)</i></p> <p>Owner Name: <u>Mississippi Lignite Mining Co</u> Mailing Address: <u>1000 Mc Intire Road</u> <u>Ackerlyman, MS 39735</u></p> <p>City _____ State _____ Zip Code _____</p> <p>Telephone No. <u>(662) 387-5200</u></p>	<p>Well or Borehole Location</p> <p>Latitude: <u>33° 23' 05" 23 05</u> Longitude: <u>89° 15' 21" 89 15 21</u> 33° 32' 48" Method of Lat/Long (circle one): Conventional Survey, USGS quad, Hand-held GPS, <u>Survey-grade GPS</u></p> <p><u>NE 1/4 NW 1/4 Sec 33 Twn 18N Rng 10E</u></p> <p>Distance _____ Direction _____ Nearest Town _____ <u>2.5 Miles NW of Cluster</u></p>
---	--

Well / Borehole Data

Date drilling started: 9-21-06 Date drilling completed: 11-17-06 Hole depth: 190 Hole diameter: 10"

Location of the source of any surface water used for drilling: Little Bynny Creek
 Method of dosing and volume of Chlorine used in drilling and development: 1 Gal bleach to 500 Gal water

Logs run (circle all applicable): No log run Electric Gamma Ray Density Sonic Neutron Other: _____
 Name of organization running log(s): Century Geophysical Corp

Purpose of borehole (check one): Water Well Geotechnical/Geological Investigation _____ Ground Source Heat Pump _____
 Seismic Survey _____ Other (describe) _____

If drilling is not related to water well construction, skip the remainder of this block

Purpose of Well (check one): Home Industrial Public Supply Irrigation Fish Culture Other: _____

If a flowing well, method of flow regulation: Valve _____ Other (describe) _____

Static Water Level: 103 feet above or below (circle one) land surface Date measured: 11-17-06

Method of Measurement (circle one) steel tape electric tape air line other: _____

Well depth: 190 Well grouted to a depth of 140 feet Type of grout (circle one): Neat Cement Bentonite Mix _____

Casing length: 150 feet Casing diameter: 4 inches Type of casing: PVC

Screen length: 35 feet Screen diameter: 4 inches Type of screen: PVC

Screen slot size: 0.010 inches Setting depth: From 150 feet to 185 feet

Type of completion (circle all applicable): Gravel packed Underreamed Telescoped Open hole Natural Development
 Other (describe): _____

Top of lap pipe or reduction in casing: _____ feet. *If telescoped or more than one screen, describe on next page*


RECEIVED
 DEC 11 2006
 BY: OLWR

D-93

The sketch below only required for water wells

Description of formations encountered must be provided for all wells and boreholes, unless specifically exempted by regulations


If well telescopes, show depths on sketch.

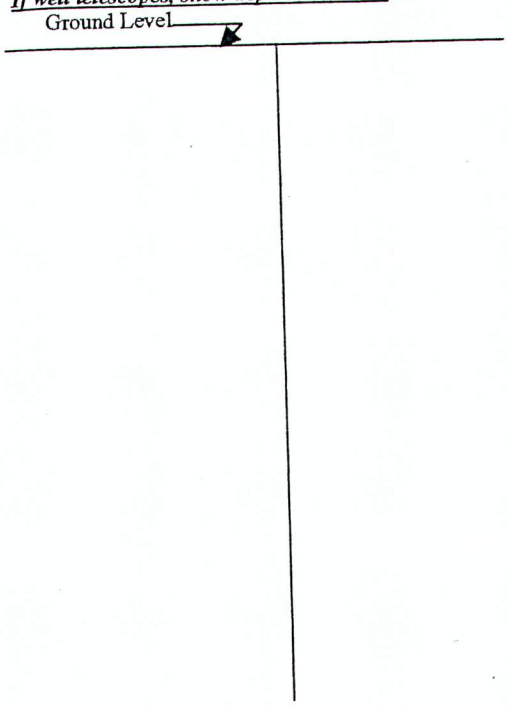

Description of Formations Encountered	From (depth)	To (depth)
SAND	Ground Level	19
lignite	19	21
SAND	21	33
lignite	33	36
CLAY	36	39
lignite	39	40
Silt	40	54
lignite	54	61
CLAY	61	76
lignite	76	81
CLAY	81	107
lignite	107	112
CLAY	112	141
lignite	141	146
CLAY	146	152
SAND	152	167
lignite	167	171
SAND	171	183
CLAY	183	190

If more than one screen, show location of each on sketch

Sketch the property layout and include the following: 1) the well location; 2) any permanent structures on the property that may aid in locating the well; 3) any roads, power lines, or other items that may aid in locating the property and the well; 4) a north arrow.

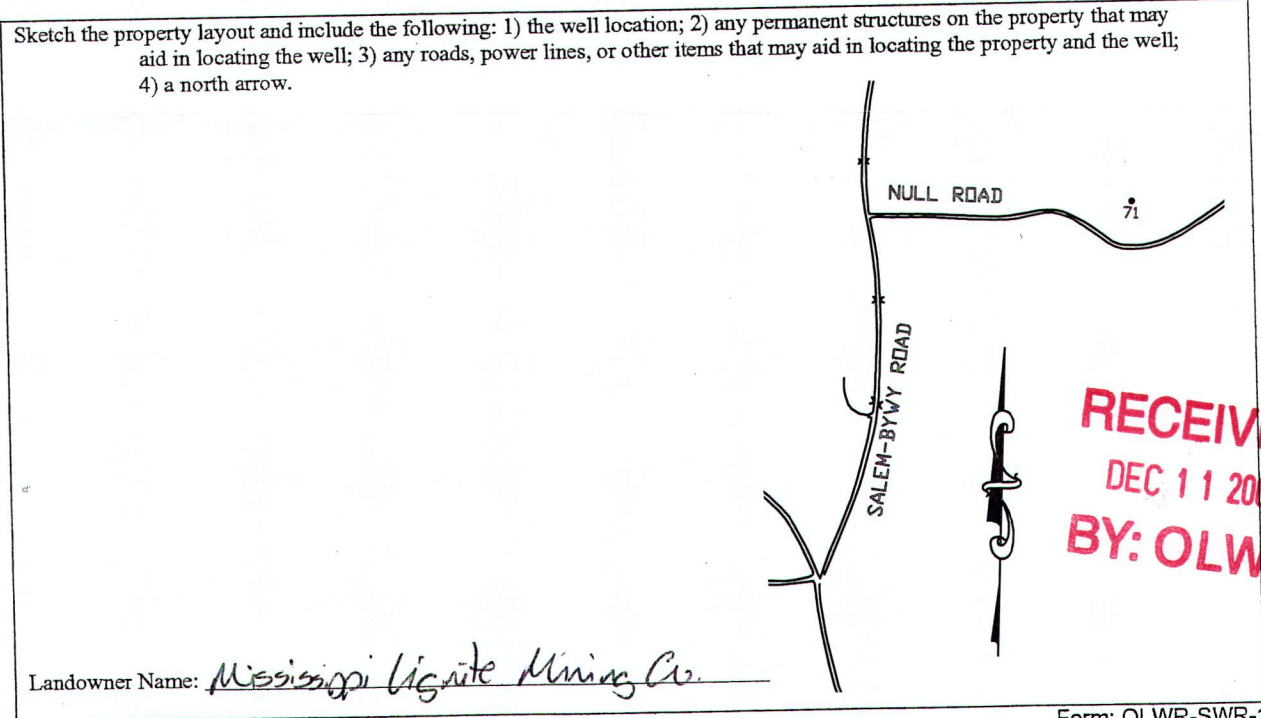

Landowner Name: Mississippi Lignite Mining Co.

Form: OLWR-SWR-1A

I certify that the well/borehole was drilled, constructed, and completed in accordance with all applicable requirements of the Mississippi Department of Environmental Quality and the Mississippi Department of Health regulations, if applicable, and state laws.

Randy SALES MS LIC 07796M 12-1-06
 Print Name of Responsible Licensee and License No. Date

Randy Sales
 Signature of Licensee

STATE WELL REPORT

Part 2

Pump Installer's Completion Report
 Mississippi Department of Environmental Quality
 Office of Land and Water Resources
 P.O. Box 10631
 Jackson, MS 39289-0631
 (601)961-5210
 (601)354-6938 (fax)

County: Choctaw
 Permit #: _____
 Driller: Randy Salers
 Date completed: 11-18-06
Copy information from block on Part 1

For Office Use Only:

Aquifer: _____
 Well #: D-93
 Elevation: _____

This part of the report must be completed by a licensed water well contractor or a licensed pump installer. A copy of Part 1 of the report must be attached and both parts filed with the Department at the above address within 30 days of well completion.

Well Owner Information	Well Location
Owner Name: <u>MS Lignite Mining Co.</u>	Latitude: <u>33° 32' 48"</u> Longitude: <u>87° 40' 02"</u>
Mailing Address: <u>1000 McJutire Rd.</u>	Method of Lat/Long (check one): Conventional Survey _____
<u>Ackerman, MS 39735</u>	USGS quad _____, Hand-held GPS _____, Survey-grade GPS <input checked="" type="checkbox"/>
City State Zip Code	<u>NE 1/4 NW 1/4 Sec 33 T18N R10E</u>
Telephone No. <u>(601) 387-5200</u>	Distance Direction Nearest Town
	<u>2.5</u> Miles <u>NW</u> of <u>Cluster</u>

Pump Type Circle one	Power Type Circle one
Air Lift Jet <input type="checkbox"/> <u>Submersible</u>	Diesel Engine Gasoline Engine Natural Gas
Bucket Piston Turbine	<u>Electric Motor</u> Hand Tractor PTO
Centrifugal Rotary Flowing Well	Windmill Other (specify): _____
Other (specify): _____	Horse Power Rating of Motor: <u>1 1/2</u>
Date Pump Installed: <u>11-18-06</u>	Setting Depth: <u>140</u> feet
Rated Pump Capacity: <u>7.5</u> Gallons Per Minute	Number of Stages: _____

RECEIVED
 DEC 11 2006
 BY: OLWR

Pump Test Data	Method of Measuring Water Level Circle one
Date Well Tested: <u>11-22-06</u>	Air Line <input type="checkbox"/> <u>Electric Measuring Line</u> Steel Tape
Static Water Level (A): <u>104</u> Feet Below Land Surface	Other (specify): _____
Pumping Water Level (B): <u>145</u> Feet Below Land Surface	For flowing well, measured shut in head: _____ feet
Drawdown [(B) - (A)]: <u>41</u> Feet Below Land Surface	Well yielded <u>3</u> GPM with a drawdown of
Test Pumping Rate: <u>3</u> Gallons Per Minute	<u>41</u> feet after <u>5</u> hours of pumping
Duration of Pump Test (minimum 4 hours): <u>5</u> hours	

I HEREBY CERTIFY that the above statements are true to the best of my knowledge.

Randy SALERS MS Lic 02779 GM
 Print Name of Pump Installer and License No. (if applicable)

Randy Salers
 Signature of Pump Installer