

County: Choctaw
 Permit #: MS Lic 0779 CM
 Driller: Randy Solers
 Date drilling completed: 11-14-06

State Well Report

Part 1 - Driller's Log

Mississippi Department of Environmental Quality
 Office of Land and Water Resources
 P.O. Box 10631
 Jackson, MS 39289-0631
 (601)961-5210
 (601)354-6938 (fax)

For Office Use Only:
 Aquifer: _____
 Well #: D-98
 L. S. Elevation: _____
 E-log #: _____

State Law requires that this report be prepared by the license holder responsible for the work and filed with the Department at the above address within 30 days of completion of drilling of the well or borehole.

Information on Well Owner (Landowner if borehole is not for a water well)	Well or Borehole Location
Owner Name: <u>MS Ugnite Mining Co.</u>	Latitude: <u>33° 32' 42"</u> Longitude: <u>87° 40' 30"</u>
Mailing Address: <u>1000 McIntire Rd.</u>	Method of Lat/Long (circle one): Conventional Survey,
<u>Ackerman, MS 39735</u>	USGS quad, Hand-held GPS, <u>Survey-grade GPS</u>
City State Zip Code	<u>NE 1/4 NE 1/4 Sec 32 Twn 18N Rng 10E</u>
Telephone No. <u>(601) 387-5200</u>	Distance Direction Nearest Town <u>2.5 Miles NW of Chester</u>

Well / Borehole Data

Date drilling started: 10-4-06 Date drilling completed: 11-14-06 Hole depth: 1125' Hole diameter: 10"

Location of the source of any surface water used for drilling: Little Byway Creek

Method of dosing and volume of Chlorine used in drilling and development: 1 gal Bleach to 500 Gal. Water

Logs run (circle all applicable): No log run Electric Gamma Ray Density Sonic Neutron Other: _____

Name of organization running log(s): Century Geophysical Corp.

Purpose of borehole (check one): Water Well Geotechnical/Geological Investigation _____ Ground Source Heat Pump _____

Seismic Survey _____ Other (describe) _____

If drilling is not related to water well construction, skip the remainder of this block

Purpose of Well (check one): Home Industrial _____ Public Supply _____ Irrigation _____ Fish Culture _____ Other: _____

If a flowing well, method of flow regulation: Valve _____ Other (describe) _____

Static Water Level: 89 feet above or below (circle one) land surface Date measured: 11-20-06

Method of Measurement (circle one) steel tape electric tape _____ air line _____ other: _____

Well depth: 105 Well grouted to a depth of 110 feet Type of grout (circle one): Neat Cement _____ Bentonite _____ Mix _____

Casing length: 125 feet Casing diameter: 4 inches Type of casing: PVC

Screen length: 35 feet Screen diameter: 4 inches Type of screen: PVC

Screen slot size: 0.010 inches Setting depth: From 175 feet to 160 feet

Type of completion (circle all applicable): Gravel packed _____ Underreamed _____ Telescoped _____ Open hole _____ Natural Development _____

Other (describe): _____

Top of lap pipe or reduction in casing: _____ feet. *If telescoped or more than one screen, describe on next page*


Form: OLWR-SWR-1A

RECEIVED
 DEC 21 2006
 BY: OLWR

The sketch below only required for water wells

Description of formations encountered must be provided for all wells and boreholes, unless specifically exempted by regulations


If well telescopes, show depths on sketch.

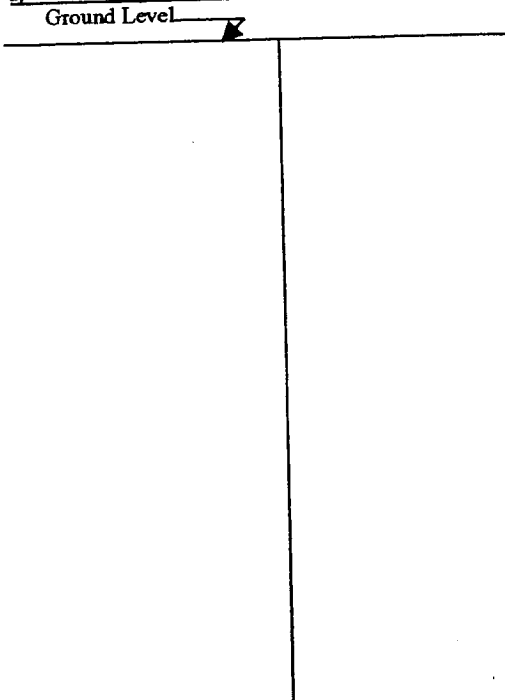

Description of Formations Encountered	From (depth)	To (depth)
SAND	Ground Level	2.5
lignite	25	26
Silt	26	48
lignite	48	54
CLAY	54	60
lignite	60	64
CLAY	64	87
lignite	87	91
CLAY	91	121
lignite	121	136
SAND	136	145
lignite	145	146
SAND	146	160
CLAY	160	165

If more than one screen, show location of each on sketch

Sketch the property layout and include the following: 1) the well location; 2) any permanent structures on the property that may aid in locating the well; 3) any roads, power lines, or other items that may aid in locating the property and the well; 4) a north arrow.

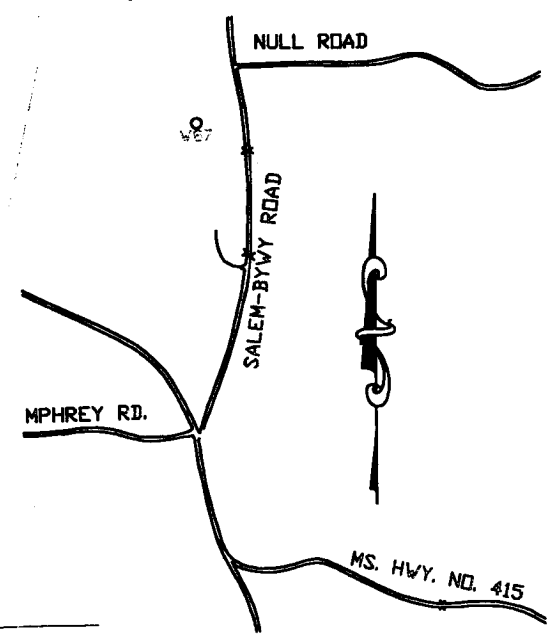

Landowner Name: Asigate Mining Co.

Form: OLWR-SWR-1A

I certify that the well/borehole was drilled, constructed, and completed in accordance with all applicable requirements of the Mississippi Department of Environmental Quality and the Mississippi Department of Health regulations, if applicable, and state laws.

Print Name of Responsible Licensee and License No. Randy SALES MSLIC 0719GM Date 12/13/06

Signature of Licensee Randy Sales

RECEIVED
DEC 21 2006
BY: OLWR

STATE WELL REPORT

Part 2

Pump Installer's Completion Report
 Mississippi Department of Environmental Quality
 Office of Land and Water Resources
 P.O. Box 10631
 Jackson, MS 39289-0631
 (601)961-5210
 (601)354-6938 (fax)

County: Quitman
 Permit #: MSLIC 0779 GM
 Driller: Zandy Sales
 Date completed: 11-20-06
Copy information from block on Part 1

For Office Use Only:

Aquifer: _____
 Well #: D-98
 Elevation: _____

This part of the report must be completed by a licensed water well contractor or a licensed pump installer. A copy of Part 1 of the report must be attached and both parts filed with the Department at the above address within 30 days of well completion.

Well Owner Information	Well Location
Owner Name: <u>MS Lignite Mining Co</u>	Latitude: <u>33°32'42"</u> Longitude: <u>87°40'30"</u>
Mailing Address: <u>1000 Mc Intire Rd</u>	Method of Lat/Long (check one): Conventional Survey _____
<u>Ackerman, MS 39735</u>	USGS quad _____, Hand-held GPS _____, Survey-grade GPS <input checked="" type="checkbox"/>
City State Zip Code	<u>SE 1/4 NE 1/4 Sec 32 T 18N R 10E</u>
Telephone No. <u>(601) 387-5200</u>	Distance Direction Nearest Town
	<u>2.5 Miles NW of Chester</u>

Pump Type Circle one	Power Type Circle one
Air Lift Jet <input checked="" type="radio"/> <u>Submersible</u>	Diesel Engine Gasoline Engine Natural Gas
Bucket Piston Turbine	<input checked="" type="radio"/> <u>Electric Motor</u> Hand Tractor PTO
Centrifugal Rotary Flowing Well	Windmill Other (specify): _____
Other (specify): _____	Horse Power Rating of Motor: <u>1/2</u>
Date Pump Installed: <u>11-20-06</u>	Setting Depth: <u>123</u> feet
Rated Pump Capacity: <u>7.5</u> Gallons Per Minute	Number of Stages: _____

Pump Test Data	Method of Measuring Water Level Circle one
Date Well Tested: <u>11-29-06</u>	Air Line <input checked="" type="radio"/> <u>Electric Measuring Line</u> Steel Tape
Static Water Level (A): <u>89</u> Feet Below Land Surface	Other (specify): _____
Pumping Water Level (B): <u>110</u> Feet Below Land Surface	For flowing well, measured shut in head: _____ feet
Drawdown [(B) - (A)]: <u>29</u> Feet Below Land Surface	Well yielded <u>3</u> GPM with a drawdown of
Test Pumping Rate: <u>3</u> Gallons Per Minute	<u>29</u> feet after <u>7</u> hours of pumping
Duration of Pump Test (minimum 4 hours): <u>7</u> hours	

I HEREBY CERTIFY that the above statements are true to the best of my knowledge.

Zandy SALES MSLIC 0779 GM Zandy Sales
 Print Name of Pump Installer and License No. (if applicable) Signature of Pump Installer

RECEIVED
 DEC 21 2006
 BY: OLWR