

State Well Report

Part 1 - Driller's Log

Mississippi Department of Environmental Quality
Office of Land and Water Resources
P.O. Box 10631
Jackson, MS 39289-0631
(601)961-5210
(601)354-6938 (fax)

For Office Use Only:

Aquifer: _____
Well #: D-107
L. S. Elevation: _____
E-log #: _____

County: CHOCTAW
Permit #: _____
Driller: RANDY SALERS
Date drilling completed: 12-3-06

State Law requires that this report be prepared by the license holder responsible for the work and filed with the Department at the above address within 30 days of completion of drilling of the well or borehole.


Information on Well Owner (Landowner if borehole is not for a water well)	Well or Borehole Location
Owner Name: <u>MISSISSIPPI LIGNITE MINING CO.</u>	Latitude: <u>33° 23' 21"</u> Longitude: <u>89° 14' 40"</u>
Mailing Address: <u>1000 MENTURE RD</u> <u>ACKERMAN MS 39735</u>	Method of Lat/Long (circle one): Conventional Survey, USGS quad, Hand-held GPS, Survey-grade GPS
City _____ State _____ Zip Code _____	<u>SW 1/4 SW 1/4 Sec 27 Twn 18N Rng 10E</u>
Telephone No. (<u>662</u>) <u>387-5200</u>	Distance _____ Direction _____ Nearest Town _____ <u>2.5 Miles NW of Chester</u>
Well / Borehole Data	
Date drilling started: <u>9-22-06</u> Date drilling completed: <u>12-3-06</u> Hole depth: <u>185</u> Hole diameter: <u>10"</u>	
Location of the source of any surface water used for drilling: <u>LITTLE BRYNNE CREEK</u>	
Method of dosing and volume of Chlorine used in drilling and development: <u>1 GAL BLEACH TO 500 GAL WATER</u>	
Logs run (circle all applicable): No log run <input checked="" type="checkbox"/> Electric <input checked="" type="checkbox"/> Gamma Ray <input checked="" type="checkbox"/> Density <input type="checkbox"/> Sonic <input type="checkbox"/> Neutron Other: _____	
Name of organization running log(s): <u>CENTURY GEOPHYSICAL CORP</u>	
Purpose of borehole (check one): Water Well <input checked="" type="checkbox"/> Geotechnical/Geological Investigation _____ Ground Source Heat Pump _____	
Seismic Survey _____ Other (describe) _____	
<i>If drilling is not related to water well construction, skip the remainder of this block</i>	
Purpose of Well (check one): Home <input type="checkbox"/> <input checked="" type="checkbox"/> Industrial <input type="checkbox"/> Public Supply <input type="checkbox"/> Irrigation <input type="checkbox"/> Fish Culture <input type="checkbox"/> Other: _____	
If a flowing well, method of flow regulation: Valve _____ Other (describe) _____	
Static Water Level: <u>131</u> feet above or below (circle one) land surface Date measured: <u>12-13-06</u>	
Method of Measurement (circle one) steel tape <input checked="" type="checkbox"/> electric tape <input type="checkbox"/> air line other: _____	
Well depth: <u>185</u> Well grouted to a depth of <u>135</u> feet Type of grout (circle one): <input checked="" type="checkbox"/> Neat Cement <input type="checkbox"/> Bentonite <input type="checkbox"/> Mix	
Casing length: <u>150</u> feet Casing diameter: <u>4</u> inches Type of casing: <u>PVC</u>	
Screen length: <u>35</u> feet Screen diameter: <u>4</u> inches Type of screen: <u>PVC</u>	
Screen slot size: <u>0.010</u> inches Setting depth: From <u>145</u> feet to <u>180</u> feet	
Type of completion (circle all applicable): <input checked="" type="checkbox"/> Gravel packed <input type="checkbox"/> Underreamed <input type="checkbox"/> Telescoped <input type="checkbox"/> Open hole <input type="checkbox"/> Natural Development	
Other (describe): _____	
Top of lap pipe or reduction in casing: _____ feet. <i>If telescoped or more than one screen, describe on next page</i>	


Form: OLWR-SWR-1A

The sketch below only required for water wells

Description of formations encountered must be provided for all wells and boreholes, unless specifically exempted by regulations

If well telescopes, show depths on sketch.


Ground Level 

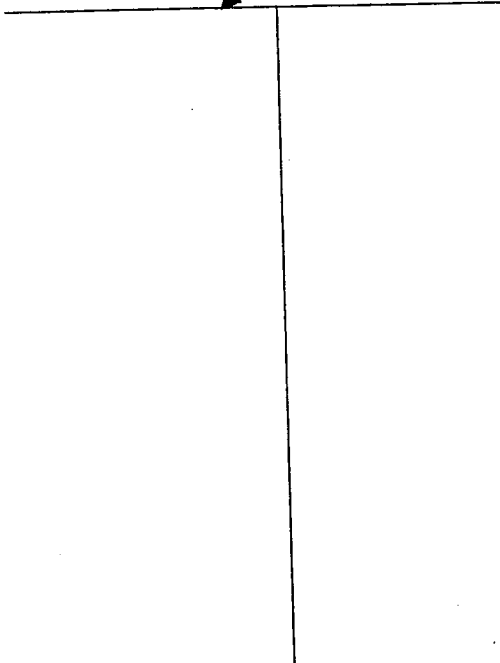

Description of Formations Encountered	From (depth)	To (depth)
SAND	Ground Level	38
LIGNITE	38	40
CLAY	40	47
SAND	47	54
CLAY	54	58
LIGNITE	58	61
CLAY	61	81
LIGNITE	81	84
CLAY	84	106
SAND	106	118
LIGNITE	118	121
CLAY	121	140
LIGNITE	140	145
SAND	145	165
LIGNITE	165	167
SAND	167	176

If more than one screen, show location of each on sketch

Sketch the property layout and include the following: 1) the well location; 2) any permanent structures on the property that may aid in locating the well; 3) any roads, power lines, or other items that may aid in locating the property and the well; 4) a north arrow.

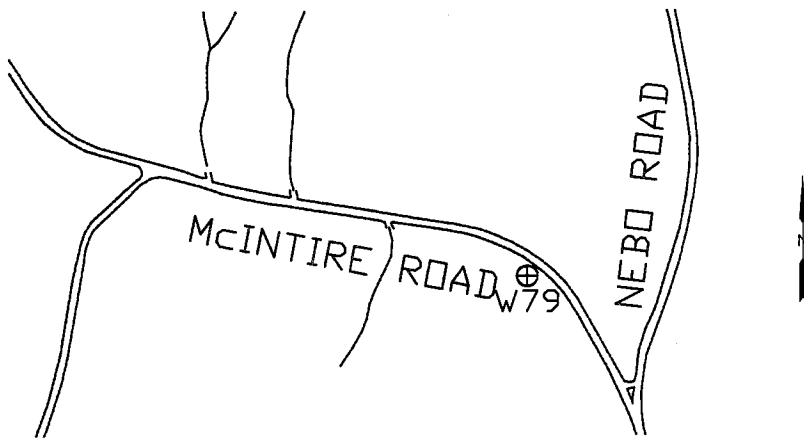

Landowner Name: MS Lignite Mining Co.

Form: OLWR-SWR-1A

I certify that the well/borehole was drilled, constructed, and completed in accordance with all applicable requirements of the Mississippi Department of Environmental Quality and the Mississippi Department of Health regulations, if applicable, and state laws.

Randy SAIFERS MS LIC 0079 GPM 4-4-07
 Print Name of Responsible Licensee and License No. Date

Randy Saifers
 Signature of Licensee

[Faint, illegible handwritten notes]

STATE WELL REPORT

Part 2

Pump Installer's Completion Report
 Mississippi Department of Environmental Quality
 Office of Land and Water Resources
 P.O. Box 10631
 Jackson, MS 39289-0631
 (601)961-5210
 (601)354-6938 (fax)

County: CHOCTAW
 Permit #: _____
 Driller: RANDY SALERS
 Date completed: 12-3-06
Copy information from block on Part 1

For Office Use Only:

Aquifer: _____
 Well #: D-107
 Elevation: _____

This part of the report must be completed by a licensed water well contractor or a licensed pump installer. A copy of Part 1 of the report must be attached and both parts filed with the Department at the above address within 30 days of well completion.

Well Owner Information	Well Location
Owner Name: <u>MISSISSIPPI LIBNITE MINING CO</u>	Latitude: <u>33°23'21"</u> Longitude: <u>89°14'40"</u>
Mailing Address: <u>1000 McINTIRE RD</u>	Method of Lat/Long (check one): Conventional Survey _____
<u>ACKERMAN MS 39735</u>	USGS quad _____, Hand-held GPS _____, Survey-grade GPS <input checked="" type="checkbox"/>
City _____ State _____ Zip Code _____	<u>SW 1/4 SW 1/4 Sec 27 T 18N R 10E</u>
Telephone No. <u>(662) 387-5200</u>	Distance _____ Direction _____ Nearest Town _____
	<u>2.5</u> Miles <u>NW</u> of <u>CLUSTER</u>

Pump Type Circle one	Power Type Circle one
Air Lift Jet <input checked="" type="radio"/> <u>Submersible</u>	Diesel Engine Gasoline Engine Natural Gas
Bucket Piston Turbine	<input checked="" type="radio"/> <u>Electric Motor</u> Hand Tractor PTO
Centrifugal Rotary Flowing Well	Windmill Other (specify): _____
Other (specify): _____	Horse Power Rating of Motor: <u>1/2</u>
Date Pump Installed: <u>12-16-2006</u>	Setting Depth: <u>143</u> feet
Rated Pump Capacity: <u>7.5</u> Gallons Per Minute	Number of Stages: _____

Pump Test Data	Method of Measuring Water Level Circle one
Date Well Tested: <u>12-17-2006</u>	Air Line <input checked="" type="radio"/> <u>Electric Measuring Line</u> Steel Tape
Static Water Level (A): <u>131</u> Feet Below Land Surface	Other (specify): _____
Pumping Water Level (B): <u>140</u> Feet Below Land Surface	For flowing well, measured shut in head: _____ feet
Drawdown [(B) - (A)]: <u>9</u> Feet Below Land Surface	Well yielded <u>3</u> GPM with a drawdown of
Test Pumping Rate: <u>3</u> Gallons Per Minute	<u>9</u> feet after <u>4</u> hours of pumping
Duration of Pump Test (minimum 4 hours): <u>4</u> hours	

I HEREBY CERTIFY that the above statements are true to the best of my knowledge.

Randy SALERS MS LIC 0079 G.M Randy Salers
 Print Name of Pump Installer and License No. (if applicable) Signature of Pump Installer

Form: OLWR-SWR-1B

RECEIVED
 APR 09 2007
 BY: OLWR