DU 37

county: Choclaw	Part 1 – I	Oriller's Log	For Office Use Only:				
1		t of Environmental Quality	Aquifer:				
Permit #: 1/13 UC 0 1 1961/1		and Water Resources	Well #: D-1/5				
Driller: RANDY SaleRS		Box 10631	Well#:				
11-)6-07	,	IS 39289-0631	L. S. Elevation:				
Date drilling completed: <u> </u>		961-5210 4-6938 (fax)	E-log #:				
	(001)33	4-0930 (IAX)	15-10g#.				
State Law requires that this report Department at the above address							
Information on Well Owner Well or Bo		orehole Location					
(Landowner if borehole is not for a water well)  Owner Name M S Ligni H Mining Co.  Mailing Address: 1000 M In Life Rd		Latitude: 33 ° 22 ', 45" Longitude: 7 ° 15', 09"  Method of Lat/Long (circle one): Conventional Survey,					
				Ackerman, MS 39735		USGS quad, Hand-held	GPS, Survey-grade GPS
						NU 1/4 SE 1/4 Sec 33	Twn ISN Rng OF
City Stat	e Zip Code	Distance Direction	Nearest Town				
Telephone No. (462) 387-520	2						
	Well / Bore	hole Data					
Date drilling started: 9-24-06 Date dri	lling completed: 1-19-1	27 Hole depth: 217	Hole diameter: 434				
Location of the source of any surface wate Method of dosing and volume of Chlorine	r used for drilling:	He Bywy veck lopment: 1 gal bleach to	500 jd noter				
Logs run (circle all applicable): No log run Name of organization running log(s):	Century Co	Bensity Sonic Neutron	Other:				
Purpose of horehole (check one): Water W.	ell Geotechnical/Geo	logical Investigation Ground	d Source Heat Pump REA				
		ari vonganou Otomi	"EUFI				
Seismic S	Name of organization running log(s): Century Cree plags ! A log D.  Purpose of borehole (check one): Water Well Geotechnical/Geological Investigation Ground Source Heat Pump RECE  Seismic Survey Other (describe)  If drilling is not related to water well construction, skip the remainder of this block						
If drilling is not related	to water well construction	n, skip the remainder of this bl	Di 1942				
Purpose of Well (check one): Home	ndustrial Public Suppl	y Irrigation Fish Culture	Other: BY: OLV				
If a flowing well, method of flow regulatio	n: Valve (	Other (describe)					
Static Water Level: 48.0 feet ab	ove or below (circle one)	land surface Date measured:					
Method of Measurement (circle one) st	cel tape electric tape	air line other:					
Well depth: 208 Well grouted to a de		e of grout (circle one): Neat Cer					
Casing length: 15/60eet Casin	ng diameter:	inches Type of casing: _	PVC				

Screen slot size: 0.01 inches Setting depth: From // feet to 2.00 feet

Other (describe):

Top of lap pipe or reduction in casing: \_\_\_\_\_\_feet. If telescoped or more than one screen, describe on next page

Type of completion (circle all applicable): Gavel packed Underreamed Telescoped Open hole Natural Development

Screen length: 40 feet

**State Well Report** 

## The sketch below only required for water wells


If well telescopes, show depths on sketch.

Ground Level

Description of formations encountered must be provided for all wells and boreholes, unless specifically exempted by regulations

Description of Formations Encountered		o (depth)
Sanol	Ground Level	33
clay	33	72
0	72	78
class	78	156
Linite	Isle	160
< And	1100	180
1: 4	180	183
Sand	183	200
2/2	200	217
Clary		

If more than one screen, show location of each on sketch

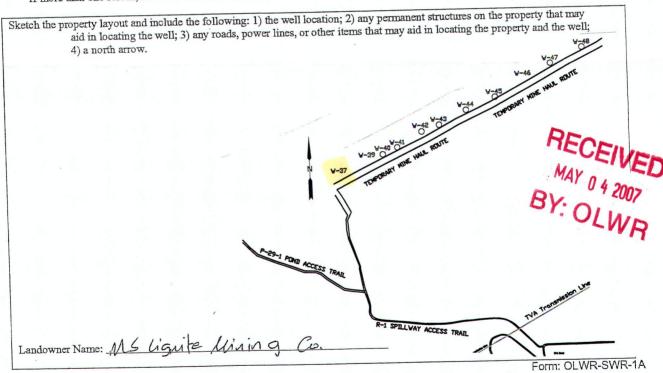

I certify that the well/borehole was drilled, constructed, and completed in accordance with all applicable requirements of the Mississippi Department of Environmental Quality and the Mississippi Department of Health regulations, if applicable, and state

RANDY Salens Mg Lic 0779 Gm 4-26-07

Print Name of Responsible Licensee and License No.

Date

Signature of Licensee

## STATE WELL REPORT

## Permit #: Driller: Rand Date completed:

## Part 2

Pump Installer's Completion Report
Mississippi Department of Environmental Quality
Office of Land and Water Resources P.O. Box 10631 Jackson, MS 39289-0631 (601)961-5210 (601)354-6938 (fax)

For Office Use Only:	
Aquifer:	
Well#: D-//5	
Elevation:	

This part of the report must be completed by a licensed water well of report must be attached and both parts filed with the Department a Well Owner Information  Owner Name: MS Light Mining Co.  Mailing Address: 1000 M Zabie Rd.	contractor or a licensed pump installer. A copy of Part 1 of the at the above address within 30 days of well completion.  Well Location		
Well Owner Information  Owner Name: M S Lignite Mining Co.	Well Location		
Owner Name: MS Lignite Mining Co.			
	2.2		
11 11 11 1000 M Y 1'00 21	Latitude: 33 <sup>b</sup> 22' 45 Longitude: 94 <sup>c</sup> 15' 08 Longitude: 94 <sup>c</sup> 15' 15' 08 Longitude: 94 <sup>c</sup> 15' 15' 15' 15' 15' 15' 15' 15' 15' 15'		
Ackerman, MS 39735			
City State Zip Code	NW 1/4 SE 1/4 Sec 33 T/8N R 10 €		
	Distance Direction Nearest Town		
Telephone No. (462) 387-5200	2.5 Miles NU of Ches Kr		
T. T.	Power Type		
Pump Type Circle one	Circle one		
Air Lift Jet Submersible	Diesel Engine Gasoline Engine Natural Gas		
Bucket Piston Turbine	Electric Motor Hand Tractor PTO		
Centrifugal Rotary Flowing Well	Windmill Other (specify):		
Other (specify):	Horse Power Rating of Motor:		
Date Pump Installed:	Setting Depth: 158 feet MAY		
Rated Pump Capacity: 7.5 Gallons Per Minute	Horse Power Rating of Motor:  Setting Depth: 158  Number of Stages:   PECEIV  feet MAY 0 4 200		
Pump Test Data	Method of Measuring Water Level		
-	Circle one		
Date Well Tested:	Air Line Electric Measuring Line Steel Tape		
	Other (specify):		
Pumping Water Level (B):Feet Below Land Surface	Can (creation)		
Drawdown [(B) – (A)]:Feet Below Land Surface	For flowing well, measured shut in head:feet		
Test Pumping Rate: Gallons Per Minute	Well yielded GPM with a drawdown of		
Duration of Pump Test (minimum 4 hours):hours	feet afterhours of pumping		

I HEREBY CERTIFY that the above statements are true to the best	of my knowledge.	
RANdy Salers Ms Lic 0779GM	Randy Salers	
Print Name of Pump Installer and License No. (if applicable)	Signature of Pump Installer	

Form: OLWR-SWR-1B