Form: OLWR-SWR-1A

State W	ell Report				
County Choffau Part 1 - I	Oriller's Log	For Office Use Only:			
Mississippi Departmen	t of Environmental Quality	Aquifer:			
	and Water Resources Box 10631	Well #: D - 1/9			
Jackson, IV	IS 39289-0631	L. S. Elevation:			
	961-5210 4-6938 (fax)	E-log #:			
	` '				
	State Law requires that this report be prepared by the license holder responsible for the work and filed with the Department at the above address within 30 days of completion of drilling of the well or borehole.				
Information on Well Owner	Well or Bor	ehole Location			
(Landowner if borehole is not for a water well)	Latitude: 33 ° 22 '52'	" Longitude: 89° 14,511"			
Owner Name MS Lignite Mining Co.	Method of Lat/Long (circle one	e): Conventional Survey,			
Mailing Address: 1000 M Inbit Rd	USGS quad, Hand-held	GPS, Survey-grade GPS			
Ackerman, MS 39735	_	Twn /8N Rng 10E			
City State Zip Code	Distance Direction 2.5 Miles No. 0	Nearest Town			
Telephone No. (462) 387-5200					
Well / Bor					
Date drilling started: 10-2-06 Date drilling completed: 12-14	P-WHole depth: 188	Hole diameter:			
Location of the source of any surface water used for drilling: Little Byw, creek Method of dosing and volume of Chlorine used in drilling and development: If Bleach to Source water					
Logs run (circle all applicable): No log run Electric Gamma Ray Density Sonic Neutron Other: Name of organization running log(s): Central Creptus: Corp.					
Purpose of borehole (check one): Water Well Geotechnical/Geological Investigation Ground Source Heat Pump ECEIVE					
Seismic Survey Other (describe) MAY 0 4 2077					
If drilling is not related to water well construction		BY OLIV			
Purpose of Well (check one): Home Industrial Public Supply Irrigation Fish Culture Other:					
If a flowing well, method of flow regulation: Valve	•				
Static Water Level: 50.3 feet above or below (circle one)					
Method of Measurement (circle one) steel tape electric tape air line other:					
Well depth: 203 Well grouted to a depth of 150 feet Typ	-				
Casing length: 155 feet Casing diameter: 4 inches Type of casing: PVC					
Screen length: 40 feet Screen diameter: 4 inches Type of screen: PVC					
Screen slot size: 0.01 inches Setting depth: From 155 feet to 195 feet					
Type of completion (circle all applicable):					
Other (describe):					
Top of lap pipe or reduction in casing:feet. If a	elescoped or more than one scre	en, describe on next page			

The sketch below only required for water wells

If well telescopes, show depths on sketch.

Ground Level


Description of formations encountered must be provided for all wells and boreholes, unless specifically exempted by regulations

Description of Formations Encountered		To (deptili)
Sand	Ground Level	24
Sand clay sand Linite Sand	24	155
Sand	155	176
Limite	1718	180
5 and	180	198
	-	

Signature of Licensee

If more than one screen, show location of each on sketch

Print Name of Responsible Licensee and License No.

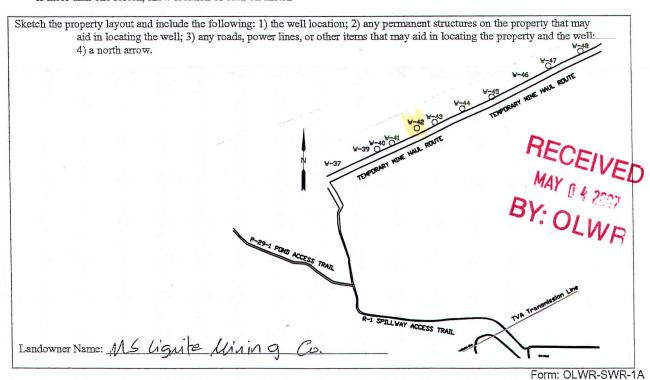

I certify that the well/borehole was drilled, constructed, and completed in accordance with all applicable requirements of the Mississippi Department of Environmental Quality and the Mississippi Department of Health regulations, if applicable, and state

Date

ic 0.779 CM 4-26-07

STATE WELL REPORT

Permit #: Driller: Date completed:

Part 2

Pump Installer's Completion Report
Mississippi Department of Environmental Quality
Office of Land and Water Resources
P.O. Box 10631
Jackson, MS 39289-0631
(601)961-5210
(601)354-6038 (fox)

For Office Use Only:		
Aquifer:		
Well#: D - //9		
Elevation:		

Copy information from block on Part 1	(601)35	4-6938 (fax)	Dividion	
This part of the report must be completed report must be attached and both parts fil	by a licensed water well of led with the Department a	contractor or a licensed pump is at the above address within 30 d	nstaller. A copy of ays of well comple	f Part 1 of the tion.
Well Owner Informa		Well Location		
Owner Name: MS Lignite M	ining lo.	Latitude: 33° 22′ 52 "	Longitude: 89	19154"
Mailing Address: 1000 M. Zahire		Method of Lat/Long (check one): Conventional Survey, USGS quad, Hand-held GPS, Survey-grade GPS SE¼_NE¼_Sec33T/8NRØE		
Ackerman, ms	39735			
City State	Zip Code			
Telephone No. (462) 387-520	W)	Distance Direction 25 Miles No o		
Telephone No. (4+C) 55 7				
Pump Type Circle one			wer Type ircle one	
Air Lift Jet (Submersible	Diesel Engine Gasolii	ne Engine	Natural Gas
Bucket Piston	Turbine	Electric Motor Hand		Tractor PTO
Centrifugal Rotary	Flowing Well		(specify):	RECO
Other (specify):	Horse Power Rating of Motor:		- CEIV	
Date Pump Installed:/-18-07		Setting Depth:		est MAY 0 4 200
Rated Pump Capacity: 7.5	Gallons Per Minute	Number of Stages:		RECEIVAY 0 4 200
Pump Test Data		Method of Me	easuring Water L	evel
Date Well Tested: 1-1-87			Circle one	
Static Water Level (A): 30, 3 Feet Below Land Surface		The state of the s	asuring Line	Steel Tape
Pumping Water Level (B): 150 Fee		Other (specify):		
Drawdown [(B) – (A)]: 99, 7 Fee	et Below Land Surface	For flowing well, measured s	hut in head:	feet
Test Pumping Rate:3	Well yielded3		1	
Duration of Pump Test (minimum 4 hours):hours	feet after _	hor	urs of pumping
I HEREBY CERTIFY that the above state	ements are true to the best	of my knowledge.		-

I HEREBY CERTIFY that the above statements are true to the best of	of my knowledge.	
RANDY Saleps 0779 GM	Ranchy Lalers	
Manay salens of 19000		
Print Name of Pump Installer and License No. (if applicable)	Signature of Pump Installer	

Form: OLWR-SWR-1B