20 46

County: Choctaw
Permit #: M3 Lic 07796M
Driller: Randy Salens
Date drilling completed: 4-26-07

## **State Well Report**

Part 1 – Driller's Log

Mississippi Department of Environmental Quality
Office of Land and Water Resources
P.O. Box 10631

Jackson, MS 39289-0631

(601)961-5210

(601)354-6938 (fax)

For Office Use Only:
Aquifer:
L. S. Elevation:
E-log #:

State Law requires that this report be prepared by the license holder responsible for the work and filed with the

Department at the above address within 30 days of completion of drilling of the well or borehole.			
Information on Well Owner	Well or Borehole Location		
(Landowner if borehole is not for a water well)	Latitude: 33 ° 22 ' 59" Longitude: 29 ° 14 ' 35"		
Owner Name MS Lignite Mining Co.  Mailing Address: MOD M Intil Rd	Method of Lat/Long (circle one): Conventional Survey,		
	USGS quad, Hand-held GPS, Survey-grade GPS		
Ackerman MS 39735	3W 14 NW 14 Sec 34 Twn (TN Rng 10E		
City State Zip Code	Distance Direction Nearest Town  2.5 Miles No of Chaster		
Telephone No. (462) 387-5200			
Well / Bore	hole Data		
Date drilling started: 10-5-04 Date drilling completed: 12-17-	· · · · · · · · · · · · · · · · · · ·		
Location of the source of any surface water used for drilling: L. +H. Method of dosing and volume of Chlorine used in drilling and devel	comment. 1 par Blecch to SUN gol water		
Logs run (circle all applicable): No log run Electric Gamma Ray Density Sonic Neutron Other:  Name of organization running log(s):  Centry Ceophysical Carp.			
Purpose of borehole (check one): Water Well Geotechnical/Geol	logical Investigation Ground Source Heat Pump		
Seismic Survey Other (describe	PFCru.		
If drilling is not related to water well construction, skip the remainder of this block			
Purpose of Well (check one): Home Industrial Public Supply	y Irrigation Fish Culture Other: MAY 9 4 2002		
If a flowing well, method of flow regulation: Valve Other (describe)			
Static Water Level: 4, 2 feet above or below (circle one)			
Method of Measurement (circle one) steel tape electric tape	air line other:		
Well depth: 198 Well grouted to a depth of 155 feet Type			
Casing length: 1 (1) feet Casing diameter: 4			
1	inches Type of screen:		
Screen slot size: O,O ( inches Setting depth: From _	(10) feet to 190 feet		
Type of completion (circle all applicable): Gravel packed Under	rreamed Telescoped Open hole Natural Development		
Other (describe):	,		
Top of lap pipe or reduction in casing:feet. If u	elescoped or more than one screen, describe on next page		

Form: OLWR-SWR-1A

## The sketch below only required for water wells


If well telescopes, show depths on sketch.

Ground Level\_

Description of formations encountered must be provided for all wells and boreholes, unless specifically exempted by regulations

Description of Formations Encountered		10 (deptil)
Jana	Ground Level	24
Class	24	140
Clas	160	175
	125	179
- Longrik	129	190
<u> </u>	190	220
Clay		100
<u> </u>		<del> </del>
	<del></del>	ļ
		+
		<del></del>
		<del></del>
		<del> </del>

If more than one screen, show location of each on sketch

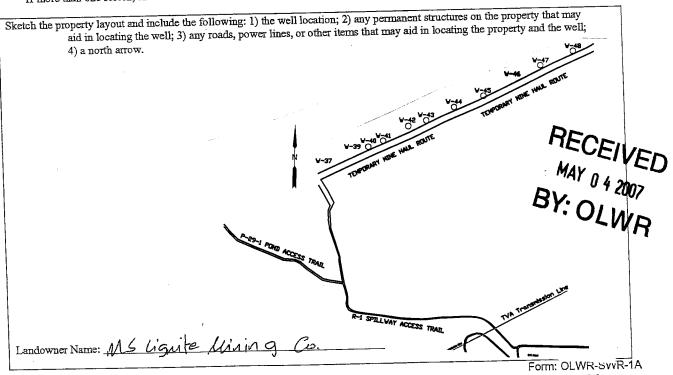

I certify that the well/borehole was drilled, constructed, and completed in accordance with all applicable requirements of the Mississippi Department of Environmental Quality and the Mississippi Department of Health regulations, if applicable, and state

Bandy Salens Ms Lic 0779 GM 4-26-67 Randy Salers

Print Name of Responsible Licensee and License No.

Date

Signature of Licensee

## STATE WELL REPORT

## Part 2

County: Chock

Date completed: \_

Permit #:

Pump Installer's Completion Report
Mississippi Department of Environmental Quality
Office of Land and Water Resources P.O. Box 10631 Jackson, MS 39289-0631 (601)961-5210 (601)354-6938 (fax)

For Office Use Only:	_
Aquifer:	
Well#: _D -123	_
Elevation:	

This part of the report must be completed by a licensed water well report must be attached and both parts filed with the Department of	contractor or a licensed pump installer. A copy of Part 1 of the at the above address within 30 days of well completion.
Well Owner Information	Well Location
Owner Name: M 5 Lignite Mining Co.	Latitude: 330 27'59' Longitude: 87° 14" 354
Mailing Address: 1000 M. Zahire Rd	Method of Lat/Long (check one): Conventional Survey,
Ackerman, ms 39735	USGS quad, Hand-held GPS, Survey-grade GPS
City State Zip Code	Distance Direction Nearest Town
Telephone No. (462) 387-5200	
Pump Type	Power Type
Circle one	Circle one
Air Lift Jet Submersible	Diesel Engine Gasoline Engine Natural Gas
Bucket Piston Turbine	Electric Motor Hand Tractor PTO
Centrifugal Rotary Flowing Well	Windmill Other (specify):
Other (specify):	Horse Power Rating of Motor:
Date Pump Installed: 1-30-07	Setting Depth: /58 feet ECF1
Rated Pump Capacity: 7, 5 Gallons Per Minute	Number of Stages:
Pump Test Data	Method of Measuring Water Level
Date Well Tested:	Circle one
Static Water Level (A): 64. Feet Below Land Surface	Air Line Electric Measuring Line Steel Tape
Pumping Water Level (B): 155 Feet Below Land Surface	Other (specify):
Drawdown [(B) – (A)]: 40 Feet Below Land Surface	For flowing well, measured shut in head:feet
Test Pumping Rate:Gallons Per Minute	Well yieldedGPM with a drawdown of hours of pumping

I HEDEDY CEDTIEVA AND A TOMAN AND A AND A SE		
I HEREBY CERTIFY that the above statements are true to the best of	my knowledge.	
Randy Salers MSLie 0779 GM	Randy Saleis	
nandy salers Mistie 01170M	Manay Salles	
Print Name of Pump Installer and License No. (if applicable)	Signature of Pump Installer	

Form: OLWR-SWR-1B